

KANSAS

Section 31 Township 8 Range 19W

Well No. 1 Osdrasek

Company Heathman & Honaker

Hayden

NORTH

WEST

EAST

							0

SOUTH

Sec. 31 Twp. 8 R. 19W ✓

Well No. #1 Osdrasek Farm

Heathman & Honaker Company


Hayden Pool

_____ Ft. from N. Line

330' Ft. from S. Line

330' Ft. from E. Line

_____ Ft. from W. Line

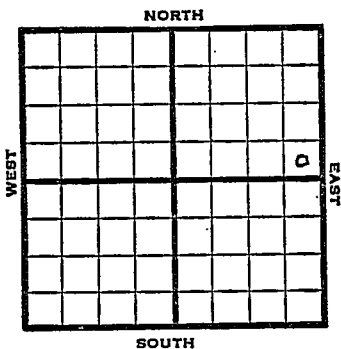

SE NE

1949 Elev 2049' REPORT

- 4/13 8" @ 181'
Anhy 1532'
Drlg. 2021'
- 4/20 Lansing 3249'
Drlg 3494'
- 4/27 Arb. 3495'
5" @ 3496'
TD 3582
500 acid
- 5/4 2000 acid
Swb 50 bbls oil PH
- 5/10 "
- 5/18 TD 3502'
Arb. 3495'
5" @ 3496'
2500 acid
Echo Pot 1217 oil
28° Gr.
Comp

COMPLETED

Map No. _____ Sec. 31 Twp. 8 R. 19W

Well No. 1 Osdrasek

Heathman & Honaker Company

FIRST REPORT

Contractor

SE NE

SECTION PLAT

_____ Ft. from N. Line
330 Ft. from S. Line
330 Ft. from E. Line
_____ Ft. from W. Line

Rooks County

Location _____

Rig up _____

Drilling and Remarks:

8" @ 181

Anhy. 1532

drlg. 2021

RECORD

Cased _____ in., _____ ft.

Sand _____

Gas _____

Oil _____

Total Depth _____

PRODUCTION

1st 24 hrs. Nat. _____

1st 24 hrs. after shot _____

Gas _____ Cu. Ft.

Dry Hole _____

Abandoned _____

Date

APR 13 1949 19

S. J. LEWIS

Scout

