

KANSAS

Section 31 Township 8 Range 19W

Well No. 1 Oudrasek

Company Heathman & Honaker

Hayden

NORTH

| | | | | | | | |
|--|--|--|--|--|--|---|--|
| | | | | | | | |
| | | | | | | | |
| | | | | | | o | |
| | | | | | | | |
| | | | | | | | |
| | | | | | | | |
| | | | | | | | |
| | | | | | | | |

WEST

EAST


SOUTH

Sec. 31 Twp. 8 R. 19W ✓

Well No. #1 Oudrasek Farm
Heathman & Honaker Company

Hayden (Heathman & Honaker, Cont.)
Pool

 Ft. from N. Line
990' Ft. from S. Line
990' Ft. from E. Line
 Ft. from W. Line

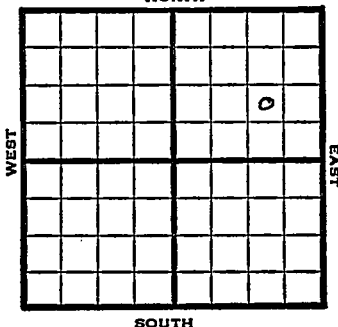

NW SE NE

1949 ELEV 2051' REPORT

7/13 8" @ 152'
Anhy. 1521'
Drlg. 2533'

7/20 Lansing 3260'
Arb. 3507'-09'
TD 3509'
5" @ 3508'

7/27 TD 3514'
500 acid

8/3 1000 acid

8/10 28 shots 3508-12
1000 acid
VSSO
TD 3535
1000 acid

8/17 TD 3535'
Arb. 3507'
5" @ 3508'
Aband.

ABANDONED

Kansas

Map No. _____ Sec. 31 Twp. 8 R. 19WWell No. 1 OudrasekHeathman & Honaker CompanyHeathman & Honaker Contractor

NW SF NE

FIRST REPORT
SECTION PLAT

_____ Ft. from N. Line

990 Ft. from S. Line990 Ft. from E. Line

_____ Ft. from W. Line

| | | | |
|--|--|--|---|
| | | | |
| | | | o |
| | | | |
| | | | |

Rooks County

Location _____

Rig up _____

Drilling and Remarks:

8" @ 152

Anhy 1521

drlg. 2533

RECORD

Cased _____ in., _____ ft.

Sand _____

Gas _____

Oil _____

Total Depth _____

PRODUCTION

1st 24 hrs. Nat. _____

1st 24 hrs. after shot _____

Gas _____ Cu. Ft.

Dry Hole _____

Abandoned _____

Date

JUL 13 1949

19

S. J. LEWIS

Scout

Kansas

Map No. A 165 Sec. 31 Twp. 8 R. 19WWell No. 1 Oudrasek

Heathman Drlg.

Company

ABANDONED

Contractor


NW SE NE

E. 2051.
SECTION PLAT

_____ Ft. from N. Line

990 Ft. from S. Line990 Ft. from E. Line

_____ Ft. from W. Line

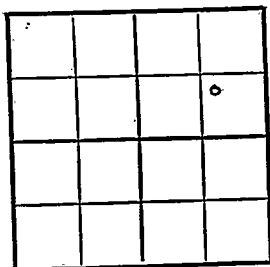

Rooks County

Location _____

Rig up _____

Drilling and Remarks:

Cu 435075" Cu 3508**RECORD**

Cased _____ in., _____ ft.

Sand _____

Gas _____

Oil _____

Total Depth 3530**PRODUCTION**

1st 24 hrs. Nat. _____

1st 24 hrs. after shot _____

Gas _____ Cu. Ft.

Dry Hole _____

Abandoned _____

Date

AUG 17 1949 19S. J. LEWIS Scout