
FORM 51 25M 8-50 WESTERN

Rooks KANSAS

Section 31 Township 8 Range 19W

Well No. #4 Ondrasek

Company Heathman Drlg.

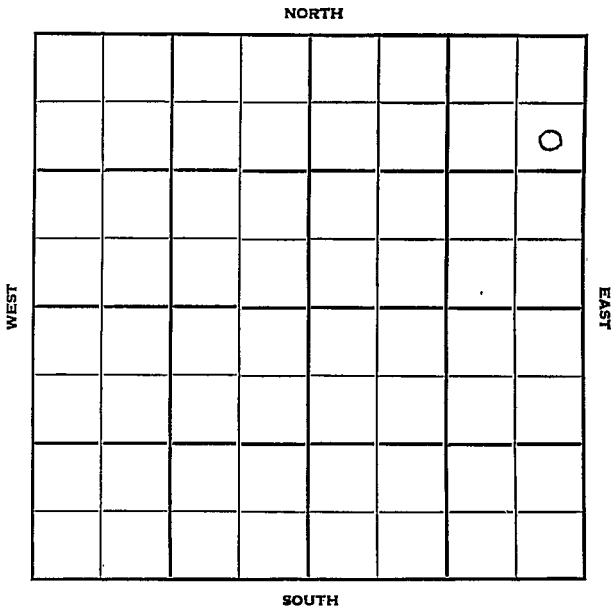

FORM 252-B
10M 9-49 PETROL

KANSAS Rooks

Sec. 31 Twp. 8 R. 19-W

Well No. #4 Ondrasek Farm

Heathman Drlg. Company

Heathman Contractor

Hayden


990 Ft. from N. Line

Ft. from S. Line

330 Ft. from E. Line

Ft. from W. Line

SE NE NE

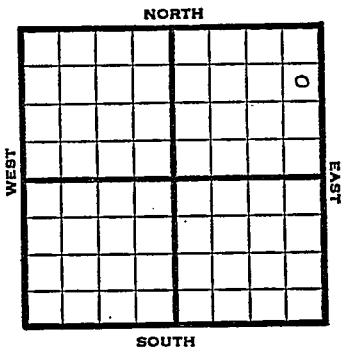

1950	Elev. 2052' REPORT
10/11	Spud 10-7-50 8" @ 110 drlg 1380
12/6	Spud 10-7-50 Oil Well TD 3510 8" @ 110' Anhy 1535' Top. 3014' Heeb 3220' Lans. 3257' DST 3285-3310 opn 15 min Rec. 370' fluid 60' o &gcm 310' sw DST 3413-22 opn 20 min Rec. 5' mud DST 3426-63 opn 20 min Rec. 7' mud BKC 3478 Arb. 3507-09 5"@ 3508' TD 3510 SSO 250 A S/2-3/4 boph 1000 A S/7 boph Comp. 290 bopd COMPLETED

FORM 275 FOR SALE BY KANSAS BLUE PRINT CO.


County Rooks State Kansas

Sec. 31 (Blk. Twp.) 8 (Sur. Rge.) 19W Map No.

Operator Heathman Drlg.

Well No. 4 Farm Ondrasek

Elev. Location SE NE NE

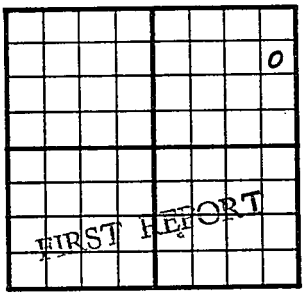

990 Ft. From N Line NE

330 Ft. From E Line Quarter

1st. Report OCT 11 1950

Completion

Remarks Heathman Drlg. - Contr.

Spudding Date 10-7-50

Drlg. Data Hayden Pool

8" @ 110 drlg. 1380

J. E. TYRA

FORM 275 FOR SALE BY KANSAS BLUE PRINT CO.


County Rooks State Kansas

Sec. 31 (Blk. Twp.) 8 (Sur. Rge.) 19W Map No.

Operator Heathman Drlg.

Well No. 4 Farm Ondrasek

Elev. 2052 Location SE NE NE

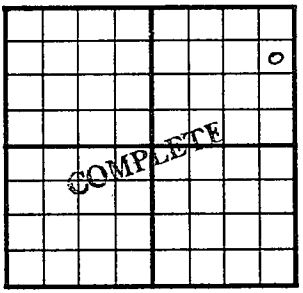

990 Ft. From N Line NE

330 Ft. From E Line Quarter

1st. Report

Completion DEC 6 1950

Remarks Hayden Pool
Heathman Drlg. - Contr.

Spudding Date 10-7-50

Drlg. Data Oil well TD 3510

8" @ 110 Anhy 1535 Top. 3014

Heeb. 3220 Lans. 3257 DST 3285-3310

open 15 min. Rec. 370' fluid 60' o & gcm

310' sw DST 3413-22 open 20 min.

Rec. 5' mud DST 3426-63 open 20 min.

Rec. 7' mud B KC 3478 Arb. 3507-09

5" @ 3508 TD 3510 SSO 250 A

S/ 2 3/4 boph 1000 A S/ 7 boph

Comp. 290 bopd

J. E. TYRA