

Rooks


KANSAS

DX 78-1

Section 31 Township 8 Range 20N

Well No. #1 Schwaller

Company L.J. Dreiling

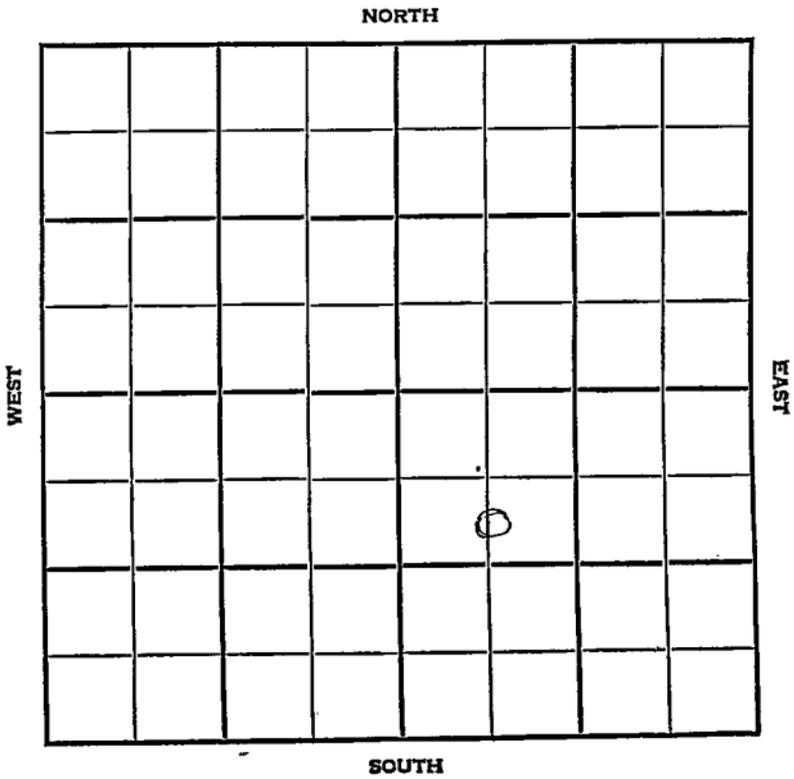

WILDCAT

FORM 513 SUNRAY

County Rooks Elev. 2067
 Sec. 31 Twp. 8 Rge. 20W
 Company L. J. Dreiling
 FarmName Schwaller No. 1

TOPS	DEPTH	LOG	DATUM
Anh.	1640		
Tp.			
H.			
Tr.			
Dg.			
Bl.			
L.			
K.C.			
B.K.C.			
Ce.			
C.			
M.			
M.			
K.			
Mz.			
Me.			
V.			
S.			
S.			
A.			
R.			
PE.			
G.			
T.D.			

Loc. in Sec. C S/2 NW SE
 Geol. Pat Simmons
 Contr. Sidey Tools
 Pool Wildcat

DEC 5
FIRST REPORT

Date Comm. 11-25-56 (TITE HOLE)
8" @ 218 w/150, Drlg. 3263

~~3~~

Co.

Se.

No.

Sec.

T.

R.

Co.

County Rooks Elev. 2067
 Sec. 31 Twp. 8 Rge. 20W
 Company L. J. Dreiling
 Farm Name Schwaller No. 1

	TOPS	DEPTH	LOG	DATUM
Anh.		1640		
Tp.				
H.				
Tc.		3311		
Dg.				
Bl.				
L.	MARTIN	3590		
K.	639	3329		
BKC.				
Ce.				
C.	3649	3558		
M.				
M.				
K.				
Mz.				
Me.				
V.				
S.				
S.				
A.				
R.				
PE.				
G.				
TD.		3663		

Loc. in Sec. C S/2 NW SE
 Geol. Pat Simmons
 Contr. Sidey Tools

Pool Wildcat
 ABANDONED
 APR 10 '57

1st

No.

Sec.

T.

R.

Date Comm. 11-25-56 (TITE HOLE)
8" @ 218 w/150, Drlg. 3263 DEC 12 '56 DEC 19 '56
DEC 26 '56 ✓ JAN 2 '57 ✓ JAN 9 '57 ✓ JAN 15 '57 ✓
JAN 23 '57 ✓ JAN 30 '57 ✓ FEB 6 '57 ✓ ✓ FEB 20 '57 ✓
FEB 27 '57 ✓ MAR 6 '57 ✓ MAR 13 '57 ✓ MAR 20 '57 ✓ MAR 27 '57 ✓
APR 3 '57 ✓ APR 10 '57

D e a