


Section 27 Township 8 Range 32-W

Well No. #1 Ryan

Company Ramsey Petr. & John Mabee

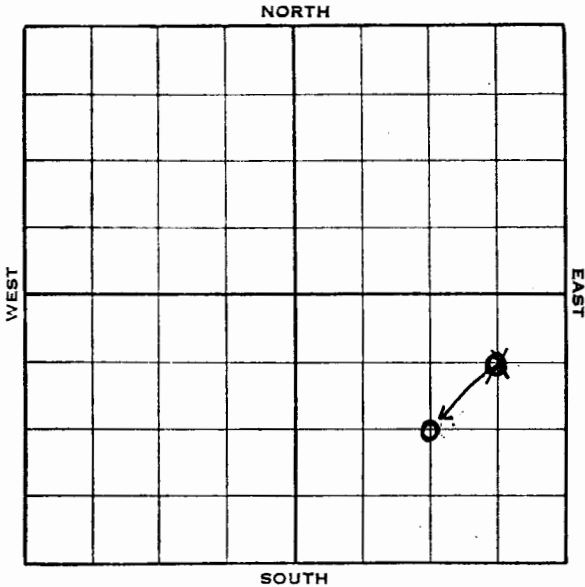

9

Thomas KANSAS

Map No. NM Sec. 27 Twp. 8 R. 32W

Well No. 1 Ryan

**Ramsey Petroleum & John Mabee**  
Company

Contractor

FIRST REPORT

C NE SE

SECTION PLAT

660 Ft. from N. Line

\_\_\_\_\_ Ft. from S. Line

660 Ft. from E. Line

\_\_\_\_\_ Ft. from W. Line

			○

Location X

RECORD

Rig up \_\_\_\_\_

Drilling and Remarks:

Cased \_\_\_\_\_ in., \_\_\_\_\_ ft.

Sand \_\_\_\_\_

Gas \_\_\_\_\_

Oil \_\_\_\_\_

Total Depth \_\_\_\_\_

PRODUCTION

1st 24 hrs. Nat. \_\_\_\_\_

1st 24 hrs. after shot \_\_\_\_\_

Gas \_\_\_\_\_ Cu. Ft.

Dry Hole \_\_\_\_\_

Abandoned \_\_\_\_\_

Date

AUG 10 1938 19 \_\_\_\_\_

H. D. Hatfield Scout

Thomas KANSAS

Map No. NM Sec. 27 Twp. 8 R. 32<sup>w</sup>

Well No. 1 - Ryan

Ramsay Pet. & John Mabee Company

Contractor

CSE

CORRECTION

SECTION PLAT


\_\_\_\_\_ Ft. from N. Line

1320 Ft. from S. Line

1320 Ft. from E. Line

\_\_\_\_\_ Ft. from W. Line

CORRECTION

Location \_\_\_\_\_

Rig up \_\_\_\_\_

Drilling and Remarks:

*first reported  
as CNE SE  
Corrected to  
CSE*

RECORD

Cased \_\_\_\_\_ in., \_\_\_\_\_ ft.

Sand \_\_\_\_\_

Gas \_\_\_\_\_

Oil \_\_\_\_\_

Total Depth \_\_\_\_\_

PRODUCTION

1st 24 hrs. Nat. \_\_\_\_\_

1st 24 hrs. after shot \_\_\_\_\_

Gas \_\_\_\_\_ Cu. Ft.

Dry Hole \_\_\_\_\_

Abandoned \_\_\_\_\_

Date

AUG 23 1938

19

H. D. Hatfield

Scout

Thomas **KANSAS**

Map No.                      Sec. 27 Twp. 8 R. 32W

Well No. 1 Ryan

**Ramsey Petrol. & John Mabee** Company

Contractor

ABANDONED

C SE


\_\_\_\_\_ Ft. from N. Line

1320 Ft. from S. Line

1320 Ft. from E. Line

\_\_\_\_\_ Ft. from W. Line

**SECTION PLAT**

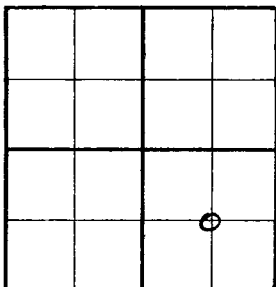

Location \_\_\_\_\_

Rig up \_\_\_\_\_

Drilling and Remarks:

Fort Hayes 1150  
 Greenhorn 1550  
 Dakota 1598  
 Fort Riley 3340  
 Base Florence F. 3430  
 Wre Ford 3480  
 Neva 3683  
 Topoka 4190  
 K.C. 4536  
 Miss 4644  
 Arb 5170  
 T.D. Date 5312

**RECORD**

Cased \_\_\_\_\_ in., \_\_\_\_\_ ft.  
 Sand \_\_\_\_\_  
 Gas \_\_\_\_\_  
 Oil \_\_\_\_\_  
 Total Depth \_\_\_\_\_

**PRODUCTION**

1st 24 hrs. Nat. \_\_\_\_\_  
 1st 24 hrs. after shot \_\_\_\_\_  
 Gas \_\_\_\_\_ Cu. Ft.  
 Dry Hole \_\_\_\_\_  
 Abandoned \_\_\_\_\_

NOV 10 1938 19 **E. D. Hatfield** Scout



1938

11/16 Fort Hayes 1150'.  
Green horn 1550'.  
Dakota 1598'.  
Fort Riley 3340'.  
Base Florence F. 3430'.  
Wreford 3480'.  
Neva 3683'.  
Topkea 4190'.  
K. C. 4536'.  
Miss. 4644'.  
Arb. 5170'.  
T. D. 5312'.

ABANDONED

3083