


Section 32 Township 8 Range 18W

Well No. #1 Hardcock

Company Derby Oil et al

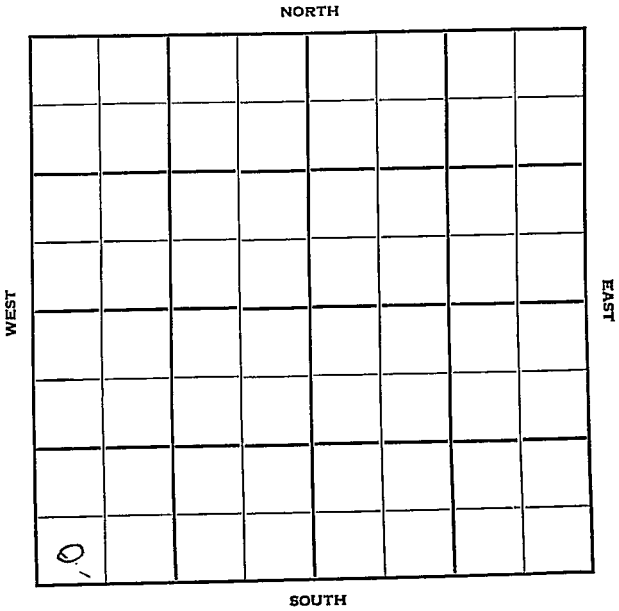

Rooks

KANSAS

18W

Sec. 32 Twp. 8 R. 18W

Well No. #1 Hardcock Farm

Derby Oil et al Company

Contractor

Barry East


Ft. from N. Line

330' Ft. from S. Line

Ft. from E. Line

330' Ft. from W. Line

SW SW SW

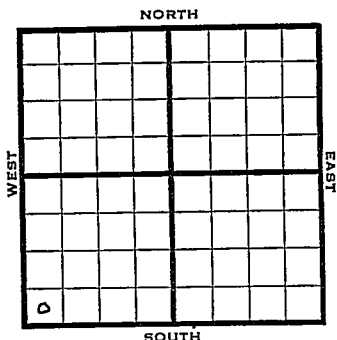

1950

Elev. 2063' REPORT

2/8

RUR

3/1

8-5/8" @ 201'

Hebb 3213'

Cong 3505'

Arb. 3508'

D&A TD 3530'

ABANDONED

350 8 3/5
20 6 3/5
4 3/5
1

Form 26 200 Bks. 11-49 Petrol **Kansas**

Barry East

Map No. _____ Sec. 32 Twp. 8 R. 18W


Well No. 1 Hardcock

Derby Oil etal. Company

Contractor

SW SW SW

SECTION PLAT

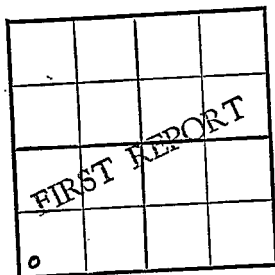

_____ Ft. from N. Line

330 Ft. from S. Line

_____ Ft. from E. Line

330 Ft. from W. Line

Rooks County

Location _____

Rig up _____

Drilling and Remarks:

R U R

RECORD

Cased _____ in., _____ ft.

Sand _____

Gas _____

Oil _____

Total Depth _____

PRODUCTION

1st 24 hrs. Nat. _____

1st 24 hrs. after shot _____

Gas _____ Cu. Ft.

Dry Hole _____

Abandoned _____

Date

FEB 8 1950

J. E. TYRA Scout

Map No. _____ Sec. 32 Twp. 8 R. 18W

Well No. 1 Hardcock

Derby Oil etal. Company

Contractor


E1.2063
SECTION PLAT

 Ft. from N. Line

330 Ft. from S. Line

 Ft. from E. Line

330 Ft. from W. Line

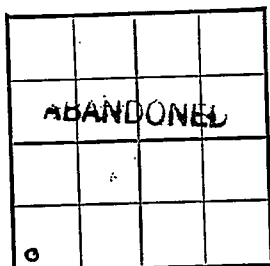

Rooks County

Location _____

Rig up _____

Drilling and Remarks:

8 5/8" @ 201
Heel 3213
Long 3252
Cong 3505
ant 3508
D & A.

RECORD

Cased _____ in., _____ ft.

Sand _____

Gas _____

Oil _____

Total Depth 3530

PRODUCTION

1st 24 hrs. Nat. _____

1st 24 hrs. after shot _____

Gas _____ Cu. Ft.

Dry Hole _____

Abandoned _____

Date

MAR 1 1950

J. E. TYRA Scout