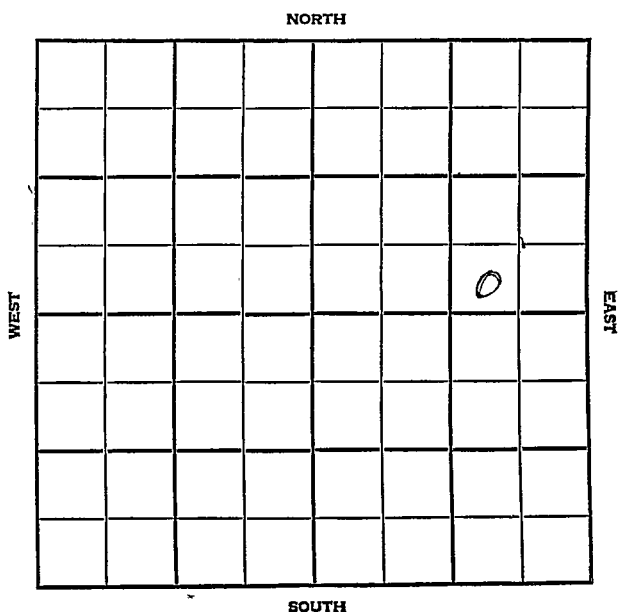


Section 32 Township 8 Range 18WWell No. #1 WelchCompany Carl Todd

County Rooks

Elev. _____

Sec. 32 Twp. 8Rgs. 18WCompany Carl ToddFarm Name WelchNo. 1

TOPS

DEPTH

LOG

DATUM

Anh.

Tp.

H.

Tr.

Dg.

Bl.

L.

K.C.

B.K.C.

Ce.

C.

M.

M.

K.

Mz.

Mo.

V.

S.

S.

A.

R.

P.E.

G.

T.D.

Loc. in Sec. _____

SW SE NE

Geol. _____

Contr. _____

Co. tools

Pool _____

Carmichael Ext.

NOV 7 1956

FIRST REPORT

Date Comm. 11-6-568" @ 200/100 WOCGet S von0.2

County Rooks Elev. 2045
 Sec. 32 Twp. 8 Rge. 18W
 Company Carl Todd
 Farm Name Welch No. 1

TOPS	DEPTH	LOG	DATUM	Loc. in Sec.
Anb.	1450			SW SE NE
Tr.	2972			
H.	3191			
Tr.	3211			
Dg.				
Bl.				
L.	3231			Geol.
K.C.				Contr.
B.K.C.				Co. tools
Ce.				Pool
C.				Carmichael Ext.
M.				
M.				
K.				
Mz.				
Mo.				
V.				
S.				
S.				
A.	3489			
R.				
PE.				
G.				
T.D.	3520			

NOV 23 '56

ABANDONED

Date Comm. 11-6-56

8" @ 200/100 WOC NOV 13 '56

DST 3198-3278 on the sec 26' Md
 (550) 960/20" DST 3278-3315
 on 38" sec 10' Md. All pres o
 ID 3435 NOV 21 '56 DST 3482-95 gel
 on sec 7' Md BHP. 0/2's

D&A