


Rooks

SECTION 32 TOWNSHIP 8 RANGE 16W

WELL NO. #1 Adams

COMPANY Cook & Galloway

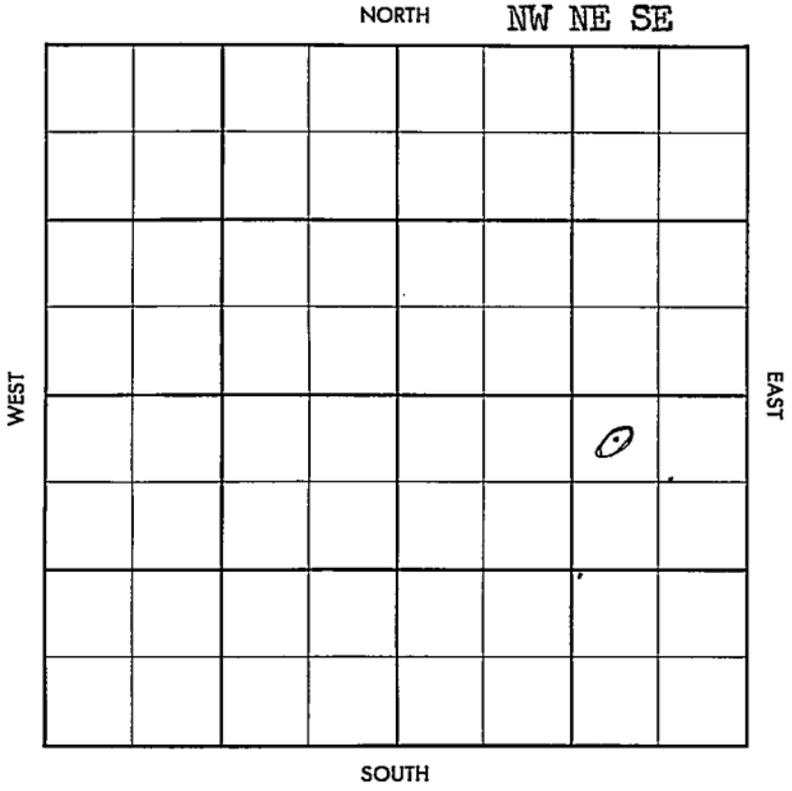

County Rooks Elev. _____
 Sec. 32 Twp. 8 Rge. 16W
 Company Cook & Galloway
 FarmName Adams No. 1

TOPS	DEPTH	LOG	DATUM
Anh.			
Tp.			
H.			
Tr.			
Dg.			
Bl.			
L.			
K.C.			
B.K.C.			
Ce.			
C.			
M.			
M.			
K.			
Mz.			
Me.			
V.			
S.			
S.			
A.			
R.			
Pe.			
G.			
T.D.			

Loc. in Sec. NW NE SE

Geol. _____

Contr. Co. tools

Pool _____

Laton

FIRST REPORT		
	FEB 6	57

Date Comm. MIR

Co.

Loc.

T

No.

Sec.

T

R.

County Rooks Elev. 2005 D/F
 Sec. 32 Twp. 8 Rgs. 16W
 Company Cook & Galloway
 Farm Name Adams No. 1

TOPS	DEPTH	LOG	DATUM	Loc. in Sec.
Anh.	<u>1368</u>			NE1/4 NE1/4 SE
Tr.	<u>2898?</u>			
H.	<u>3090</u>			
Tr.				
Dg.				
Bl.				
L.	<u>3101</u>			Geol. _____
K.C.				Contr. _____
B.K.C.	<u>3385</u>			Co. tools _____
Ce.				Pool _____
C.				
M.				
M.				
K.				
Mz.				<u>Laton</u>
Mo.				<div style="border: 1px dashed black; padding: 5px; text-align: center;"> ABANDONED FEB 20 '57 </div>
V.				
S.				
S.	<u>3462</u>			
A.				
R.				
PE.				
G.				
T.D.	<u>3482</u>			

Date Comm. Texas DHM
M I R FEB 13 '57 2-5-57 85/8

221/160 D ~~3082~~ 3160. FEB 20 '57

DST 3231-43 gr 30" run
10' Md. BHP 250

D&A.

Co.
No.
Sec.
T.
R.