


Section 32 Township 8 Range 17W

Well No. 1 Stamper "A"

Company Derby Oil

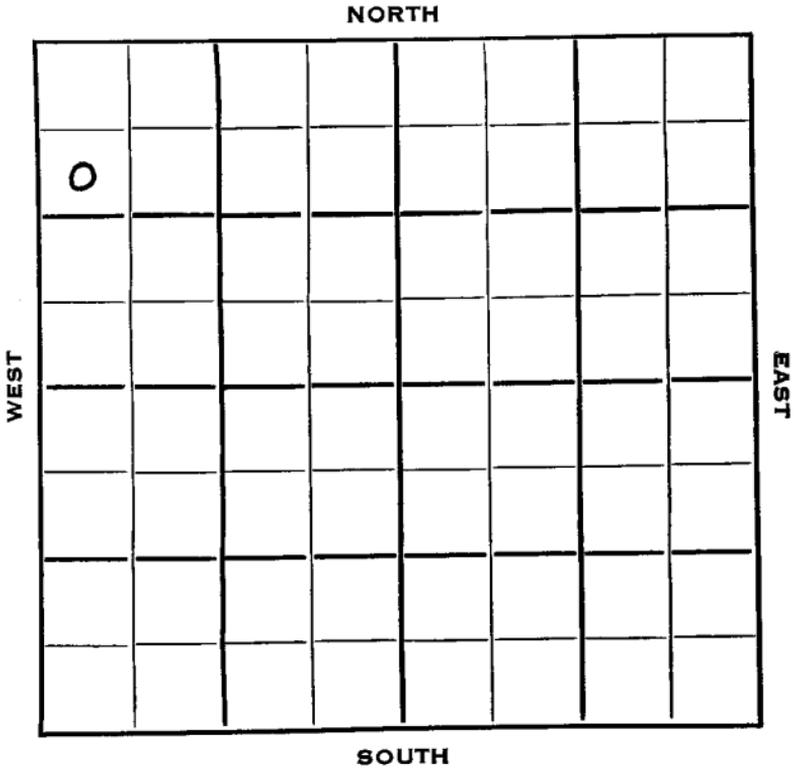

Rooks

KANSAS


SEC.	TWP.	R.
32	8	17 W ✓

WELL NO. # 1 Stamper "A" FARM

COMPANY Derby Oil

CONTRACTOR

990 Ft. from N. Line
 Ft. from S. Line
 Ft. from E. Line
 330 Ft. from W. Line

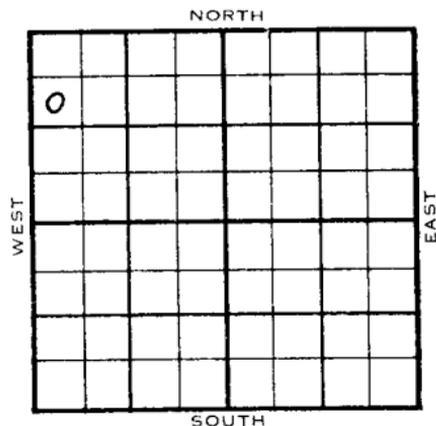

SW NW NW

	ELEVATION	REPORT
--	-----------	--------

1954	1920'	
1/13	Spud 1-10-54 8" @ 195 Drlg. 950'	
1/20	Spud 1-10-54 D & A TD 3380 8" @ 195 "eeb 3030 Lans 3071 DST 1369-76 open 1 hr rec 25' OCM 35' SW 900# DST 3262-80 open 1 hr rec 35' "OCM 2' SW 1010# Arb. 3351 DST 3352-56 open 1 hr rec 20' mud 100# DST 3353-65 open 3/4 hr rec 35' mud O TD 3380' D & A	

ABANDONED

County Rooks State KANSAS

Sec. 32 (Blk. Twp.) 8 (Sur. Rge.) 17W Map No.

Operator Derby Oil

Well No. 1 Farm Stamper "A"

Elev. _____ Location SW NW NW

o					
FIRST REPORT					

990 Ft. From N Line NW

330 Ft. From W Line Quarter

Ist. Report JAN 13 1954

Completion _____

Remarks _____

Spudding Date 1-10-54

Drlg. Data _____

8" © 195 drlg. 950

