


Rooks KANSAS

Section 32 Township 8 Range 17 W

Well No. # 3 Stamper "C"

Company Jones, Shelburne & Farmer

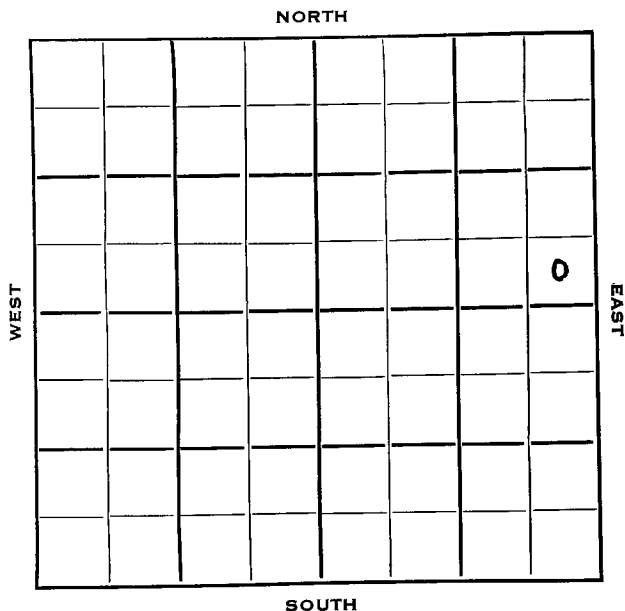

HOOKS

SEC.	32	TWP.	8	R.	KANSAS 17W ✓
------	----	------	---	----	-----------------

WELL NO.

#3 Stamper "C"

FARM

COMPANY

Jones, Shelburne & Farmer

CONTRACTOR


D & M Drlg.
Stamper Pool

_____ Ft. from N. Line

330 _____ Ft. from S. Line

330 _____ Ft. from E. Line

_____ Ft. from W. Line

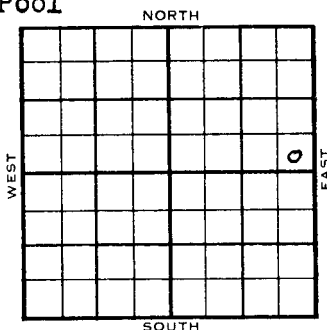

SE SE NE

	ELEVATION	REPORT
1953	1969'	
11/18	Spud 11-14-53 8" @ 157' Anhy 1275' Drlg 2145'	
12/16	CO	
1954		
1/13	Spud 11-14-53 Oil Well TD 3404' 8" @ 157' Anhy 1275', Heeb 3073', Tor 3092', Lans 3115' DST 3142'-74' opn 1 hr, rec 45' muddy sw 210' sw 1000# DST 3195'-3235' opn 1 hr, rec 660' gas 120' hocm 310' free oil, 10' wtr. 1120' Arb 3399' DST 3400'-04' opn 1 hr, rec 60' gas, 245' clean oil, 840# TD 3404' 5" @ 3400' CO to 3404' SSO 500 A S/ 3 boph Comp 131 bopd.	

COMPLETED

County **Rooks** State **Kansas**

Sec. **32** (Blk. **8** (Sur. **17W** Map No.

Operator **Jones, Shelburne & Farmer**

Well No. **3** Farm **Stamper "C"**

Elev.	Location	SE	SE	NE
-------	----------	----	----	----

[illegible]

330 Ft. From **S** Line **NE**

330 Ft. From E Line Quarter

1st. Report NOV 18 1953

Completion

Remarks

D & M Drlg. - Contr.


Spudding Date **11-14-53**

Drig. Data Stamper Pool

8" @ 157 Anhy 1275 drlg. 2145

J. G. McGEHEE

County _____ Rocks _____ State **Kansas**
 Sec. **32** (Blk.) **8** (Sur.) **17W** Map No. _____
 Operator **Jones, Shelburne & Farmer**
 Well No. **3** Farm **Stamper "C"**
 Elev. **1969** Location **SE SE NE**

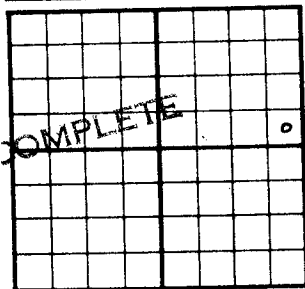

330 Ft. From S Line NE
330 Ft. From E Line Quarter

1st. Report

Completion JAN 13 1954

Remarks Stamper Pool
D & M Drlg. - Contr.

Spudding Date 11-14-53

Drlg. Data Oil well TD 3404

8" @ 157 Anhy 1275 Heeb. 3073

Ter. 3092 Lans. 3115 DST 3142-74

open 1 hr. Rec. 45' muddy sw 210' sw

1000# DST 3195-3235 open 1 hr. Rec.

660' gas 120' hoem 310' free oil

10' wtr. 1120# Arb. 3399 DST 3400-04

open 1 hr. Rec. 60' gas 245' clean oil

840# TD 3404 5" @ 3400 CO to 3404

SSO 500 A S/ 3 boph

Comp. 131 bopd

J. G. McGEHEE