

Rooks


FORM 51

KANSAS

Section 32 Township 8 Range 17W

Well No. #5 Stamper "C"

Company Jones, Shelburne & Farmer

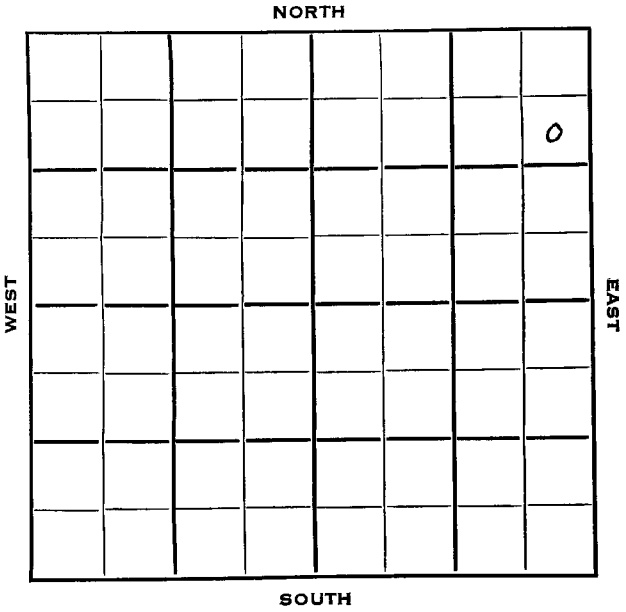

## Rooks

KANSAS

SEC.	TWP.	R.
32	8	17 W ✓

WELL NO.

# 5 Stamper "C"

FARM

COMPANY

Jones, Shelburne &amp; Farmer

CONTRACTOR

J-S-F

E. Dopita Pool

1290

Ft. from N. Line


Ft. from S. Line

330

Ft. from E. Line

Ft. from W. Line

SE NE NE

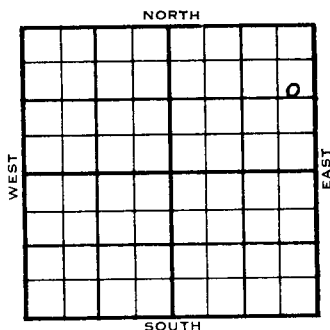

1954

ELEVATION

1965'

REPORT

2/10

RUR

2/17

8" @ 162 Anhy 1277 Heeb 3071

Tor 3091 Lans 3112

DST 3194-3214 1 hr, 600' oil + SSW  
970#

Drlg. 3320'

2/24

B KC 3302 Arb 3398

RTD 3404

DST 3398-3404, 1 hr, 30' gas, 125'

GCO, 60' MCO 820# 5" @ 3399

3/3

CO 3404 S/1/2 BOPH 250 A

S/4 1/2 BOPH 4 hrs.

3/10

NR

6/9

Spud 2-8-54 Oil well TD 3404'

8" @ 162 Anhy 1277 Heeb. 3071

Tor. 3091' Lans 3112

DST 3194-3214 open 1 hr rec 600'

oil &amp; SW. 970# B KC 3302 Arb. 3398

TD 3404

DST 3398-3404, open 1 hr rec 30' gas,

125' GCO, 60' MCO 820# 5" @ 3399

CO to 3404' S/1/2 BOPH 250 A

S/4 1/2 BOPH 4 hr.

Comp. 37 BOPD 65% wtr.

**COMPLETED**



