


Section 33 32 Township 8 Range 17W

Well No. #6 Stamper "C"

Company Jones Shelburne & Farmer

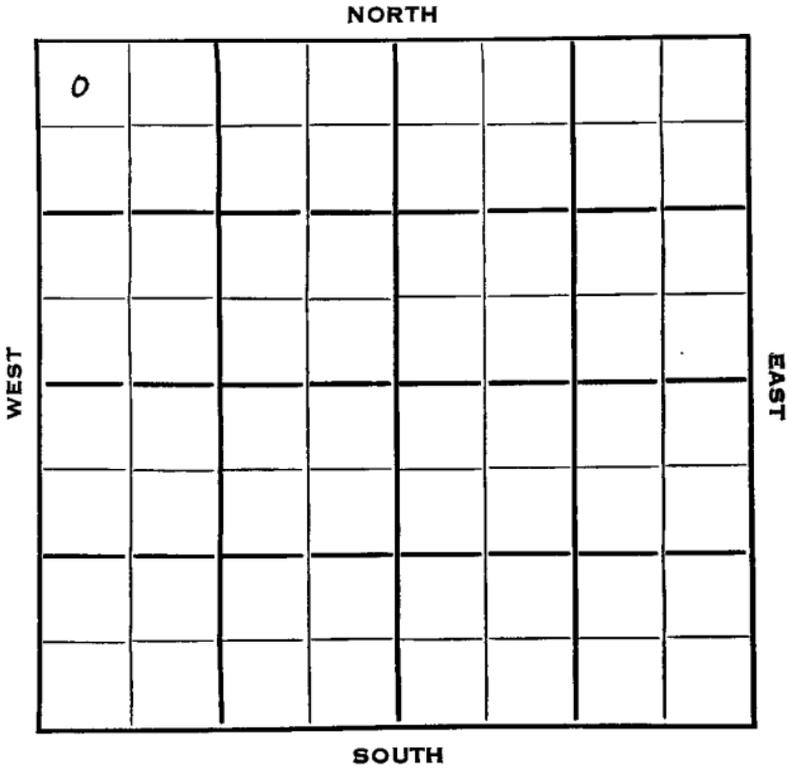

Map No. _____ Sec. 33 Twp. 8 R. 17WWell No. 6 Stamper "C"Jones, Sheburne & Farmer Company**CORRECTION**

Contractor

NW NE NW

SECTION PLAT

330 Ft. from N. Line

_____ Ft. from S. Line

_____ Ft. from E. Line

330 Ft. from W. Line

0			

Rooks County

Location _____

Rig up _____

Drilling and Remarks:

Reported

32-8-17W

RECORD

Cased _____ in., _____ ft.

Sand _____

Gas _____

Oil _____

Total Depth _____

PRODUCTION

1st 24 hrs. Nat. _____

1st 24 hrs. after shot _____

Gas _____ Cu. Ft.

Dry Hole _____

Abandoned _____

Date

MAR 10 195419J. G. MCGEHEE

Scout

County _____ **Rooks** State **Kansas**

Sec. **32** (Blk.) **8** (Sur. Rge.) **17W** Map No. _____

Operator **Jones, Shelburne & Farmer**

Well No. **6** Farm **Stamper "C"**

Elev. _____ Location **NW NW NW**

0					

330 Ft. From **N** Line **NW**

330 Ft. From **W** Line **Quarter**

1st. Report **MAR 3 1954**

Completion _____

Remarks _____

J-S-F - Contr.

Spudding Date _____

Orig. Data **Stamper Pool**

Location

