


Section 32 Township 8 Range 21 W

Well No. #3 Keith "A"

Company Imperial Oil

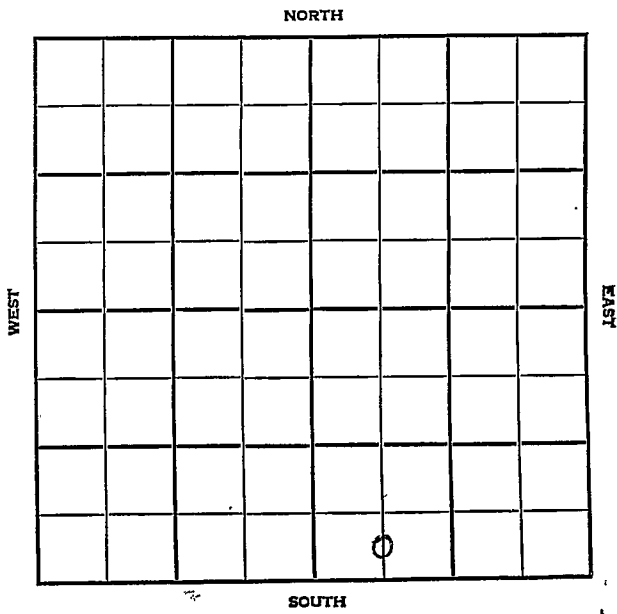

Graham

SEC.	TWP.	R.
32	8	21W

WELL NO. #3 Keith "A" FARM

COMPANY Imperial Oil

CONTRACTOR Co. Tools


Holley

_____ Ft. from N. Line

_____ Ft. from S. Line

_____ Ft. from E. Line

_____ Ft. from W. Line

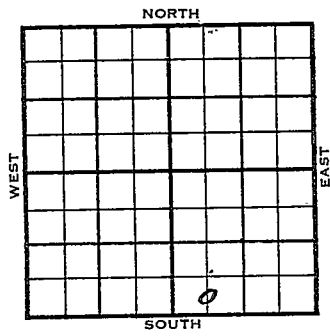

C S $\frac{1}{2}$ SW SE

1956	ELEVATION 2427'	REPORT
------	--------------------	--------

3-7 Comm. 3-3-56
8" @ 222/175
Drlg. 2655

3-14 DST 3910-26 op $\frac{1}{2}$ hr. rec. 10' mud, 0#
DST 3880-3926 op $\frac{1}{2}$ hr. rec. 10' mud,
30#
D & A
Anh. 2125
H. 3723
L. 3761
TD 4000'

ABANDONED

County Graham Elev. _____
 Sec. 32 Twp. 8 Rge. 21W
 Company Imperial Oil
 Farm Name Keith #1A No. 3

TOPS	DEPTH	LOG	DATUM
Anh.			
Tp.			
H.			
Tr.			
Dg.			
Bl.			
L.			
K.C.			
B.K.C.			
Ce.			
C.			
M.			
M.			
K.			
Mz.			
Ma.			
V.			
S.			
S.			
A.			
R.			
PE.			
G.			
T.D.			

Loc. in Sec. C S $\frac{1}{2}$ SW SE
 Geol. _____
 Contr. Co. tools
 Pool Holley
FIRST REPORT
 MAR 7 '56

Date Comm. 3-3-56
8" @ 222/175 drlg. 2655

[Handwritten signature]

Co.
 Sec.
 No.
 Sec.
 T.
 R.

County Graham Elev. 2427
 Sec. 32 Twp. 8 Rge. 24W
 Company Imperial Oil
 Farm Name Keith "A" No. 3

Co.

TOPS	DEPTH	LOG	DATUM	Loc. in Sec.																														
Anh.	2125			C S ¹ / ₄ SW SE																														
TP.																																		
H.	3723																																	
Tr.																																		
Dg.																																		
BL.																																		
L.	3761		1334	Geol.																														
K.C.				Contr.																														
B.K.C.				Co. tools																														
Ce.																																		
C.				Pool																														
M.				Holley																														
M.				<table border="1"> <tr><td></td><td></td><td></td></tr> <tr><td></td><td></td><td></td></tr> <tr><td></td><td></td><td></td></tr> <tr><td></td><td></td><td></td></tr> <tr><td></td><td></td><td></td></tr> <tr><td></td><td></td><td></td></tr> <tr><td></td><td></td><td></td></tr> <tr><td></td><td></td><td></td></tr> <tr><td></td><td></td><td></td></tr> <tr><td></td><td></td><td></td></tr> </table>																														
K.																																		
Mz.																																		
Me.																																		
V.																																		
S.																																		
S.																																		
A.																																		
R.																																		
PE.																																		
G.																																		
TD.	4000																																	

Lse.

No.

Sec.

T.

R.

Date Comm. 3-3-56 MAR 14 1956

8" @ 222/175 DST 3910-26 open $\frac{1}{2}$ hr.

rec. 10' mud 0# DST 3880-3926

open $\frac{1}{2}$ hr. rec. 10' mud 30#

D & A

ABANDONED