


Section 32 Township 8 Range 24 W

Well No. #2 Keith "B"

Company Imperial Drilg.

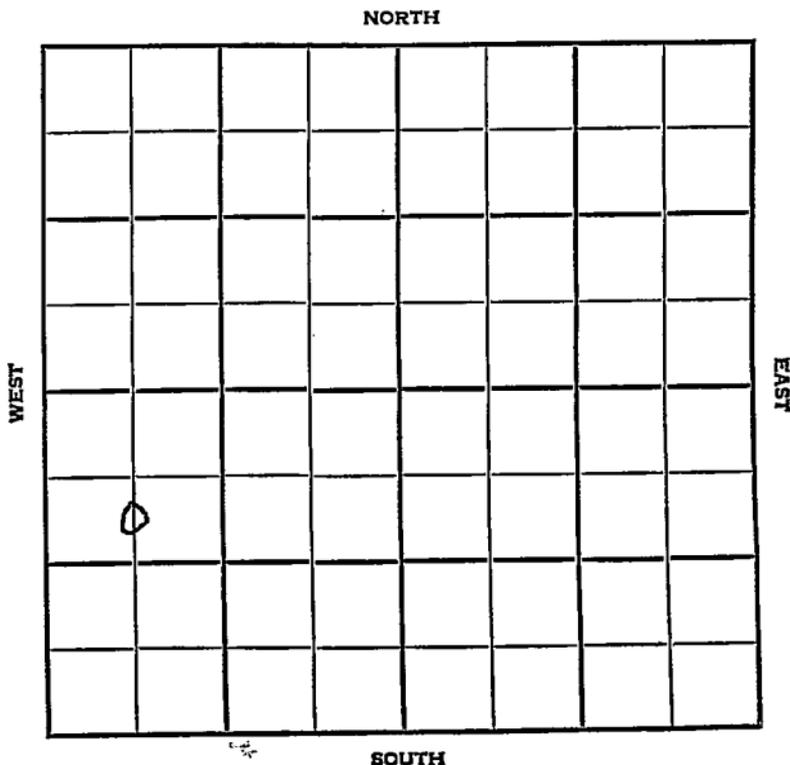

12

Graham

KANSAS

SEC. 32	TWP. 8	R. 24W
------------	-----------	-----------

WELL NO.

#2 Keith "B"

FARM

COMPANY

Imperial Drlg.

CONTRACTOR

Co. Tools


NW Holly

_____ Ft. from N. Line

_____ Ft. from S. Line

_____ Ft. from E. Line

_____ Ft. from W. Line

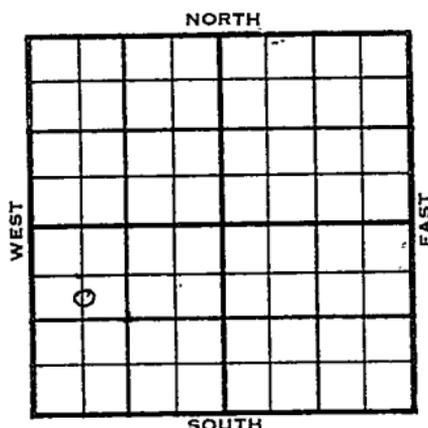C S $\frac{1}{2}$ NW SW

1956

ELEVATION

2447'

REPORT

2-29

Comm. 2-24-56

8" @ 213/175

3/28

Comm 2-24-56

Anh 2110

L 3784

TD 3974

8" @ 213/175

DST 3932-50 open 1 hr rec 2100'

GIP 100' HOCM 100' free oil

740/20" 5 1/2" @ 3974/100 CO to

3950 36/3938-44 S/3 boph 4000 A

S/21 BOPH 8 hr Comp 331 bopd

COMPLETED

County Graham Elev. 2447
 Sec. 32 Twp. 8 Rge. 24W
 Company Imperial Drlg.
 Farm Name Keith "B" No. 2

TOPS	DEPTH	LOG	DATUM	Loc. in Sec.
Anb.				C S $\frac{1}{2}$ NW SW
Tr.				
H.				
Dg.				
BL.				
L.				Geol.
K.C.				Contr.
B.K.C.				Co. tools
Ce.				Pool
C.				NW Holly
M.				FIRST REPORT
M.				
K.				
Mz.				
Mo.				
V.				
S.				
S.				
A.				
R.				
PE.				
G.				
TD.				

Date Comm. 2-24-56
8" @ 213/175

[Handwritten signature]

Co.

Use

No.

Sec.

T.

R.

County Graham Elev. 2447
 Sec. 32 Twp. 8 Rgs. 24W
 Company Imperial Drlg.
 Farm Name Keith "B" No. 2

Co.

TOPS	DEPTH	LOG	DATUM
Anb.	2110		
Tr.			
H.			
Tr.			
Dg.			
BL.			
L.	3784		1337
K.C.			
B.K.C.			
Ce.			
C.			
M.			
M.			
K.			
Mz.			
Me.			
V.			
S.			
S.			
A.			
R.			
PE.			
G.			
T.D.	3974		

Loc. in Sec. C S¹/₂ NW SW
 Geol. _____
 Contr. _____
 Co. tools _____
 Pool NW Holly
 COMPLETE
 MAR 28 '56

Use

No.

Sec.

T.

R.

Date Comm. 2-24-56
 8" @ 213/175 DST 3932-50 open 1 hr.
 rec. 2100' GIP 100' hocm 100' free oil
 740/20" 5¹/₂" @ 3974/100 GO to 3950
 36/ 3938-44 S/ 3 boph 4000 A
 S/ 21 boph 8 hr. Comp. 331 bopd