

Graham


KANSAS

SECTION 32 TOWNSHIP 8 RANGE 24 W

WELL NO. #4 Keith

COMPANY Francis Oil & Gas

NORTH

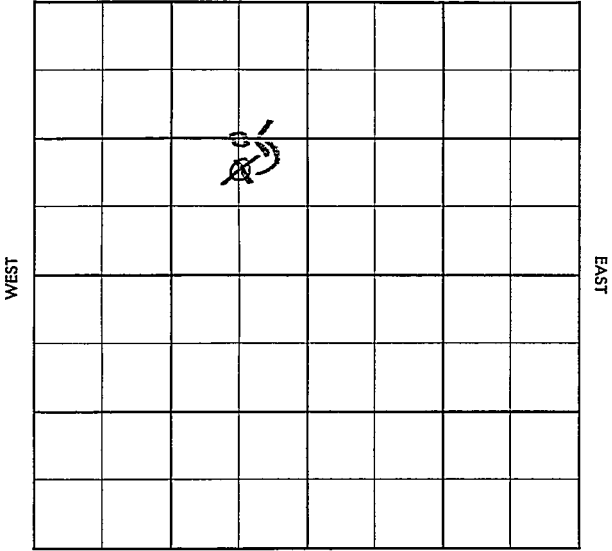

SOUTH

3

Graham

KANSAS

SEC. 32	TWP. 8	R. 24W
------------	-----------	-----------

WELL NO. #4 Keith FARM

COMPANY Francis Oil & Gas *d K & E*

CONTRACTOR K & E


NW Holly

_____ Ft. from N. Line

_____ Ft. from S. Line

_____ Ft. from E. Line

_____ Ft. from W. Line

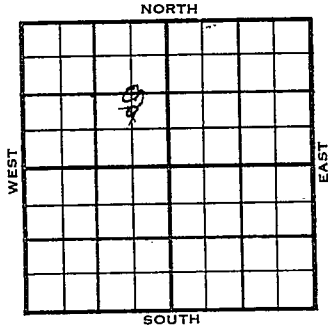

~~C N 1/2 SE NW~~

E/2 of NW

1955	ELEVATION	REPORT
12-14	Comm. 12-10-55 8" @ 211/150 Drlg. 2120	

County Graham Elev. _____
 Sec. 32 Twp. 8 Rge. 2 4W
 Company Francis Oil & Gas
 FarmName Keith No. 4

TOPS	DEPTH	LOG	DATUM	Loc. in Sec.
	2061			C N $\frac{1}{2}$ SE NW
Anb.				
Tr.				
Dg.				
Bl.				
L.				Geol. _____
K.C.				Contr. _____
B.K.C.				
Ce.				K & E
C.				
M.				Pool _____
M.				NW HOLLY
K.				
Mz.				
Me.				
V.				
S.				
S.				
A				
R.				
Pe.				
G.				
T.D.				

FIRST REPORT
 DEC 14 '55

Date Comm. 12-10-55
8" @ 211/150 drlg. 2120

[Handwritten signature]

Co.
 Use.
 No.
 Sec.
 T.
 R.

CORRECTION

Form OIS Rev. 5-27-54

~~Holly~~

3

County Grading Elev. 2361
 Sec. 32 Twp. 8 Rge. 2 NW
 Company Francis Oil & Gas (C, K & E)
 Farm Name Keith

TOPS	DEPTH	LOG	DATUM	Loc. in Sec.
Ark.	2061			6 NW 34
Tp.				
H.	3666		1305	<u>E2 of NW</u>
Tr.				
Dg.				
Bl.				
L.	3709		-1348	
KC.				Geol.
RNC.	3918		1557	Conte
Ce.				<u>K & E</u>
C.				
M.				Pool
M.				<u>NW Holly</u>
K.				
Mr.				
Mo.				
V.				
S.				
S.				
A.				
R.				
PC.				
G.				
TS	3930			

COMPLETE

Date Comm. 12-10-55 FEB 29 1956

8" @ 211/150 drlg. 2120 DEC 21 '55

DST 3853-20 lba 360' gaa
 + 20' SACM + 115' HOCM + 5'
 Free oil BHP 860/20 5 1/2 @

DEC 28 '55 5 1/2 @ 3930 JAN 5 '56 20'

3861-66 12 1/2 @ 48 BO NW
 12 lba POP JAN 11 '56 ✓ JAN 18 '56 ✓

JAN 25 '56 W/O POT FEB 1 '56 ✓ FEB 8 '56 ✓

FEB 16 '56 FEB 22 '56 FEB 29 '56 Ph P. 153