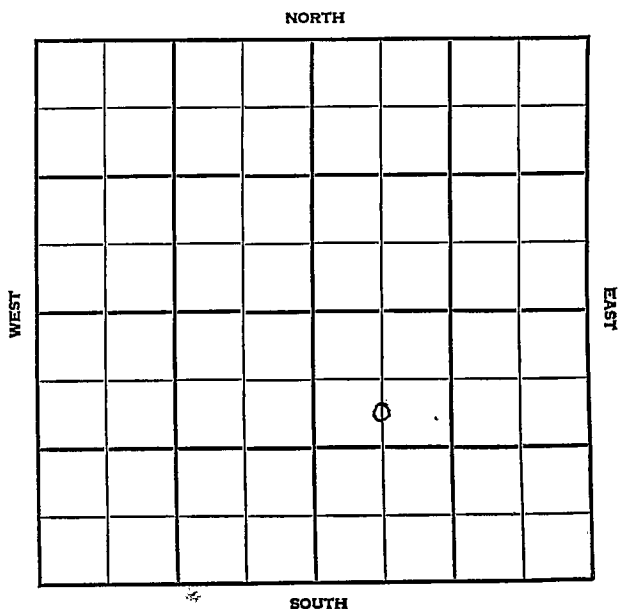


Section 32 Township 8 Range 24 WWell No. #1 Keith "A"Company Imperial Drlg.

Graham

KANSAS

SEC.	TWP.	R.
32	8	24W

WELL NO.

#1 Keith "A"

FARM

COMPANY

Imperial Drlg.

CONTRACTOR

Co. Tools


NW Holly

Ft. from N. Line

Ft. from S. Line

Ft. from E. Line

Ft. from W. Line

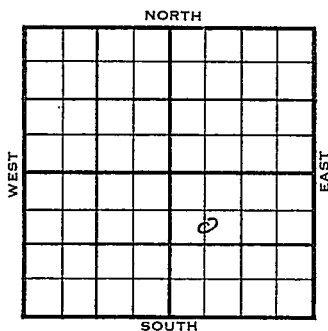C S $\frac{1}{2}$ NW SE

1955

ELEVATION

2419'

REPORT

10/5

Comm 9-30-55
Drlg 2860

11-23

8 5/8" @ 205
 DST 3893-3908 op 2 hr.rec 600' GIP, 90'
 oil 84' ocm, 1060/20"
 5 1/2" @ 3990
 CO 23/ 3901-05
 S/ 20 goph, 1000 A
 S/ 11 boph 8 hr.
 P/ 70 bopd
 Comp. 259 bopd
 Anh. 2110
 L. 3751
 TD 3990'

COMPLETED

County Graham Elev. _____
 Sec. 32 Twp. 8 Rge. 21W
 Company Imperial Drlg.
 FarmName Keith #A# No. 1

TOPS	DEPTH	LOG	DATUM	Loc. in Sec.
Anh.				<u>C S² NW SE</u>
TP.				
H.				
Tr.				
Dg.				
Bl.				
L.				Geol.
K.C.				Contr.
B.K.C.				<u>Co. tools</u>
Ce.				<u>Pool</u>
C.				<u>NW Holly</u>
M.				
M.				
K.				
Mz.				
Mq.				
V.				
S.				
S.				
A.				
R.				
PE.				
G.				
T.D.				

Date Comm. 9-30-55drlg. 2860

5

OCT 5 '55
 FIRST REPORT

County Graham Elev. 2410
 Sec. 32 Twp. 8 Rge. 24W
 Company Imperial Drlg.
 Farm Name Keith "A" No. 1

TOPS	DEPTH	LOG	DATUM	Loc. in Sec.
Anh.	2110			C S= NW SE
Tr.				
H.				
Tr.				
Dg.				
BL.				
L.	3751		1341	Geol.
K.C.				Contr.
B.K.C.				Co. tools
Ce.				
C.				
M.				
M.				
K.				
Mz.				
Mq.				
V.				
S.				
S.				
A.				
R.				
Pe.				
G.				
TD.	3990			

Pool NW Holly

COMPLETE

Date Comm. 9-30-55 NOV 23 1955

8 5/8" @ 205' DST 3893-3908 open 2 hr.

rec. 600' GIP 90" oil 84' ocm 1060/20

5 1/2" @ 3990 23/ 3901-05 S/ 20 goph

1000 A S/ 11 boph 8 hr. P/ 70 bopd

Comp. 259 bopd