

Graham

KANSAS

SECTION 32 TOWNSHIP 8 RANGE 24 W

WELL NO. #2 Keith "A"

COMPANY Kaiser, Francis & K & E

NORTH

WEST

EAST

0

SOUTH

14

Graham

KANSAS

SEC.

TWP.

R.

32

8

24W

WELL NO.

#2 Keith "A"

FARM

COMPANY

Kaiser, Francis & K & E

CONTRACTOR

K & E Drlg
NW Holley


_____ Ft. from N. Line

_____ Ft. from S. Line

_____ Ft. from E. Line

_____ Ft. from W. Line

G NL SE SW

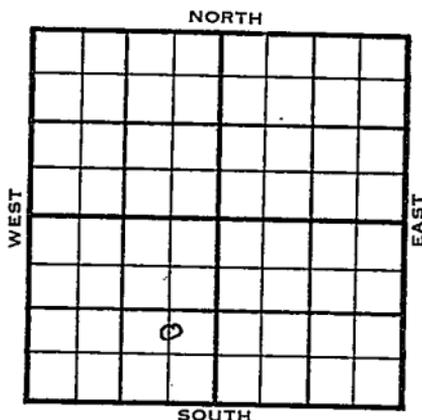

1955

ELEVATION

2401 RB, 2398 DF REPORT

10/26

Loc

12-14

Comm. 11-3-55

8 5/8" @ 201/150

DST 3876-96 op 1 hr. rec. 90' ho&gem,
200' oil, 1010/15"

5" @ 3959,

CO 16/ 3896-3900

S/ 2 1/2 BOPH, 1500 A

S/ 23 bo 2 hrs.

S/ 12 boph, 4 hrs.

Comp. 336 BOPD

Anh. 2088

H. 3696

Tr. 3719

L. 3734

BKC. 3951

TD 3960'

COMPLETED

County Graham Elev. _____
 Sec. 32 Twp. 8 Rge. 24W
 Company Keisery Francis & K & E
 Farm Name Keith No. 2

TOPS	DEPTH	LOG	DATUM
Anh.			
TP.			
H.			
Tr.			
Dg.			
Bl.			
L.			
K.C.			
B.K.C.			
Ce.			
C.			
M.			
M.			
K.			
Mz.			
Mo.			
V.			
S.			
S.			
A.			
R.			
PE.			
G.			
TD.			

Loc. in Sec. C. N. SE SW

Geol. _____
 Contr. K & E Drlg.

Popl. NW Holly

FIRST REPORT
 OCT 26 '55

Date Comm. _____
 Location _____

Co.
 No.
 Sec.
 T.
 R.

[Handwritten signature]

2101 RB

County Graham Elev. 2398 DFSec. 32 Twp. 8 Rge. 24WCompany Kaiser, Francis & K & E Drlg.Farm Name Keith "A" No. 2

TOPS	DEPTH	LOG	DATUM	Loc. in Sec.
Anh.	12088			C N $\frac{1}{2}$ SE SW
Tp.				
H.	3696		1298	1500' NL
Tr.	3719		1321	
Dg.				660' EL
Bl.				
L.	3734		1336	Geol.
K.C.				Contr.
B.K.C.	3951		1553	K & E Drlg.
Ce.				
C.				
M.				Pool
M.				NW Holly
K.				
Mz.				
Me.				
V.				
S.				
S.				COMPLETE
A.				
R.				
PC.				
G.				
TD.	3960			0

Date Comm. 11-3-55 DEC 14 19558 5/8" @ 201/150 DST 3876-96open 1 hr. rec. 90' ho & gcm 200' oil1010/15" TD 3960 5" @ 3959 CO16/ 3896-3900 S/ 2 $\frac{1}{2}$ boph 1500 AS/ 23 bo 2 hr. S/ 12 boph 4 hr.Comp. 336 bopd