

Graham


KANSAS

SECTION 32 TOWNSHIP 8 RANGE 24 W

WELL NO. #2 Keith "A"

COMPANY Imperial Oil

NORTH

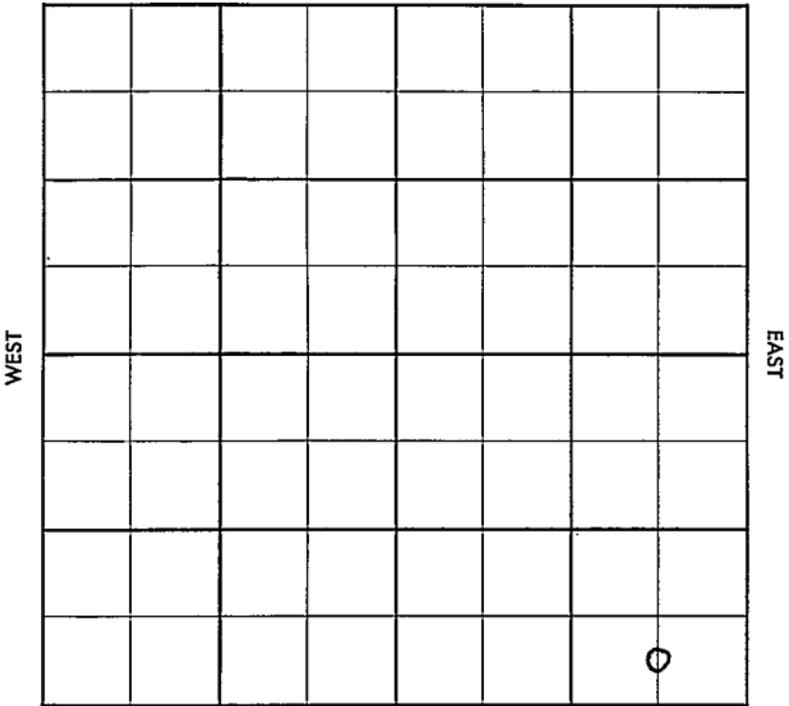

SOUTH

16

Graham

KANSAS


SEC. 32	TWP. 8	R. 24W
------------	-----------	-----------

WELL NO. #2 Keith "A" FARM

COMPANY Imperiaa Oil

CONTRACTOR Co. Tools

Holley  
 \_\_\_\_\_ Ft. from N. Line  
 \_\_\_\_\_ Ft. from S. Line  
 \_\_\_\_\_ Ft. from E. Line  
 \_\_\_\_\_ Ft. from W. Line

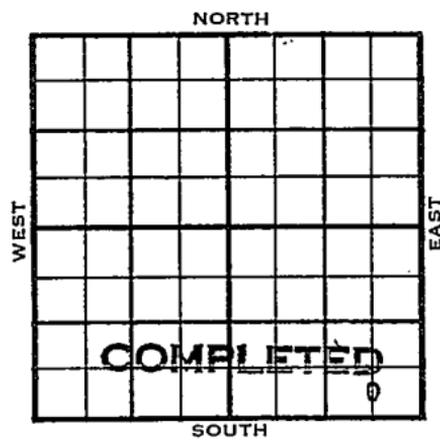

C S  $\frac{1}{2}$  SE SE

1956	ELEVATION	REPORT
------	-----------	--------

1-18-	Location	
-------	----------	--

County Graham Elev. \_\_\_\_\_  
 Sec. 32 Twp. 8 Rge. 24W  
 Company Imperial Oil  
 FarmName Keith "A" No. 2

Co.

TOPS	DEPTH	LOG	DATUM
Anh.			
Tp.			
H.			
Tr.			
Dg.			
Bl.			
L.			
K.C.			
B.K.C.			
Ce.			
C.			
M.			
M.			
K.			
Mz.			
Ma.			
V.			
S.			
S.			
A.			
R.			
PE.			
G.			
T.D.			

Loc. in Sec. C S  $\frac{1}{2}$  SE SE

Geol. \_\_\_\_\_

Contr. Co. tools

Pool Holley

FIRST REPORT		
JAN 18 1956		0

Lse.

T

No.

Sec.

T.

R.

Date Comm. \_\_\_\_\_  
 Location \_\_\_\_\_

*[Handwritten signature]*



14) \$ 34 250ph no/w 16 ma  
600' O.B. POP FEB 15 '56 ✓ FEB 22 '56 ✓  
FEB 29 '56 ✓ Ph P. 414 30pd +  
2 1/2 wtu MAR 7 '56 R 212 lag

~~Hold for 10/15~~

R.G.

MAR 1 9 1956