


Section 32 Township 8 Range 24W

Well No. #4 Keith "A"

Company Imperial

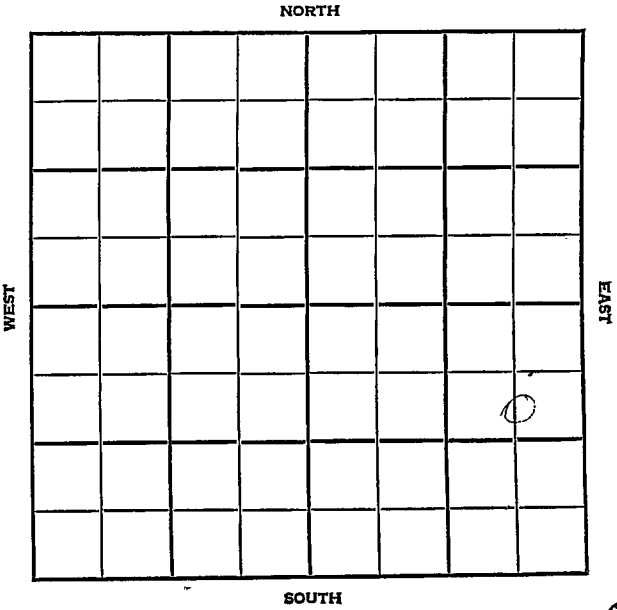

9

County Graham Elev. _____
 Sec. 32 Twp. 8 Rge. 24W
 Company Imperial
 Farm Name Keith "A" No. 4

Co.

TOPS	DEPTH	LOG	DATUM
Anh.			
Tp.			
H.			
Tr.			
Dg.			
Bl.			
L.			
K.C.			
B.K.C.			
Ce.			
C.			
M.			
M.			
K.			
Mz.			
Mq.			
V.			
S.			
S.			
A.			
R.			
Pe.			
G.			
T.D.			

Loc. in Sec. C S/2 NE SE

Geol. _____
 Contr. Harms-Burt

Tools Pool
Holley

FIRST REPORT
 OCT 24 '50

Lse.

No.

Sec.

T.

R.

Date Comm. _____

BURT

W. S. VON

Co.

County Graham Elev. 2447 RB

Sec. 32 Twp. 8 Rge. 21W

Company Imperial

FarmName Keith "A" No. 4

TOPS	DEPTH	LOG	DATUM
Anb.	2160		
TP.			
H.	3740		
Tr.	3768		
Dg.			
BL			
L.	3781		
K.C.			
B.K.C.			
Ce.			
C.			
M.			
M.			
K.			
Mz.			
Mo			
V.			
S.			
S.			
A			
R.			
PE.			
G.			
TD.	4000		

Loc. in Sec. C S/2 NE SE

Geol. _____

Contr. _____

Harms-Burt

Tools

Pool

Holley

ABANDONED

NOV 7 '56

Loc.

No.

Sec.

T.

R.

Date Comm.

BURT OCT 31 '56 10-22-56 878

198/150 # 3415 NOV 7 '56

DST 3920-42 30" nec 20' Md

BHP 70 DST 3938-4000 1 hr

nec 15' Md BHP # 15

DEA.