


Section 32 Township 8 Range 24W

Well No. #5 Keith "A"

Company Imperial

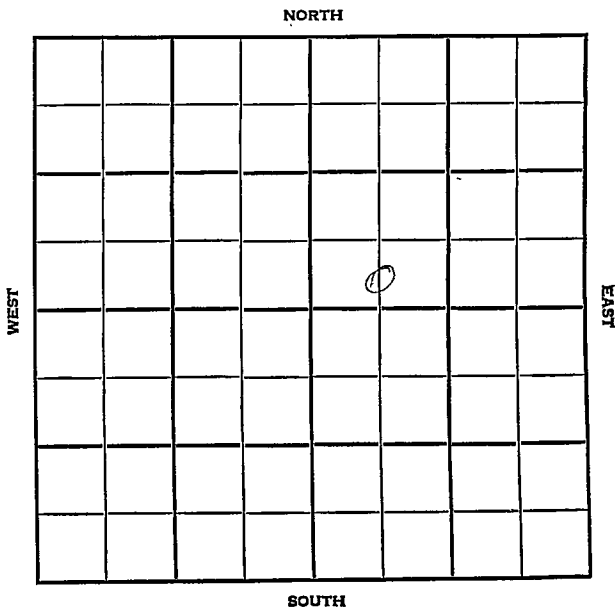

7

County Graham Elev. \_\_\_\_\_  
 Sec. 32 Twp. 8 Rgs. 24W  
 Company Imperial  
 FarmName Keith "A" No. 5

TOPS	DEPTH	LOG	DATUM
Anh.			
Tp.			
H.			
Tr.			
Dg.			
Bl.			
L.			
K.C.			
B.K.C.			
Ce.			
C.			
M.			
M.			
K.			
Mz.			
Me.			
V.			
S.			
S.			
A.			
R.			
Pe.			
G.			
J.P.			

Loc. in Sec. S/2 SW NE

Geol. \_\_\_\_\_

Contr. \_\_\_\_\_

Harms-Burt.

spools

Nolley

FIRST REPORT			
NOV 7 1955			

Date Comm. spd. 114-56  
8" @ 193 w/150, Drlg. 2080

DATE & C. NOV

*[Handwritten signature]*

Co.

Lse.

No.

Sec.

T.

R.

County Graham Elev. 2387  
 Sec. 32 Twp. 8 Rge. 24W  
 Company Imperial  
 Farm Name Keith "A" No. 5

TOPS	DEPTH	LOG	DATUM	Loc. in Sec.
Anh.				S/2 SW NE
Tr.				
H.				
Tr.				
Dg.				
Bl.				
L.	3728			
K.C.				Geol.
B.K.C.				Contr.
Ce.				
C.				Near Eurt
M.				Pools
M.				Holley
K.				
Mz.				
Mo.				
V.				
S.				
S.				
A.				
R.				
PE.				
G.				
TD.	3940			COMPLETE DEC 26 '56

Date Comm. snd. 1H-56

8" @ 193 w/150, Drlg. 2080 Nov 13 '56

DST 3870-93 2 hrs rec 70' HOCH  
BHP 130 DST 3908-40 NOV 21 '56  
op 30" rec 10' Md BHP 100  
4 1/2 3940/150 16/3881-85  
4 1/2 4 1/2 Bopk no/w 8 hrs  
Pop. NOV 28 '56 ~~RET~~ WO 5T DEC 5 '56  
WO 5T 5T. DEC 12 '56 DEC 19 '56 WO  
5T 5T. DEC 26 '56 X Ph.P. 95 Bopk  
no/w 4 1/2 3881-85 RTD 3940