

Graham

**KANSAS**


SECTION 32 TOWNSHIP 8 RANGE 24W

WELL NO. #5 Keith "B"

COMPANY Imperial Oil Co.

NORTH

C W/2 NW

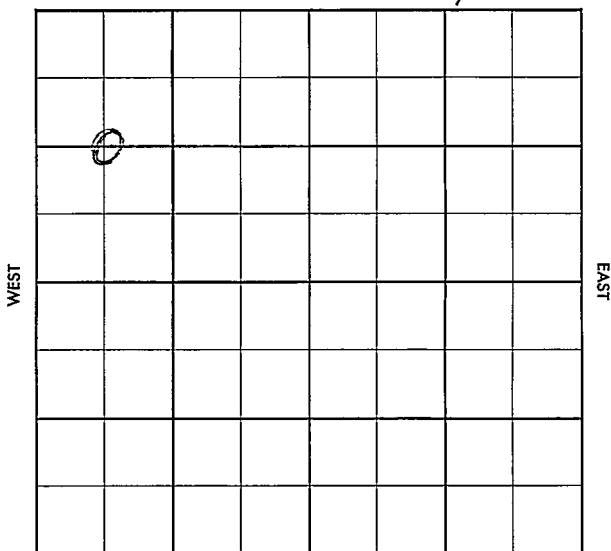

SOUTH

4

County Graham Elev. 2619 DF  
 Sec. 32 Twp. 8 Rgs. 21W  
 Company Imperial Oil Co.  
 FarmName Keith "B" No. 5

TOPS	DEPTH	LOG	DATUM	Loc. in Sec.
Anh.	2120			C W/2 NW
TP.				
H.				
Tr.				
Dg.				
Bl.				
L.				Geol.
K.C.				
B.K.C.				Contr.
Ce.				<u>Harms-Burt</u>
C.				
M.				Pool
M.				<u>Holley</u>
K.				
Mz.				
Mq.				
V.				
S.				
S.				
A.				
R.				FIRST REPORT
PE.				
G.				
T.D.				JUN 5 '57

Date Comm. 5-29-57  
8<sup>th</sup> @ 221/175, Drlg. 3365

*(Large handwritten scribble)*

Co.  
Lse.  
No.  
Sec.  
T.  
R.

County Graham Elev. 2419 DF  
 Sec. 32 Twp. 8 Rge. 24W  
 Company Imperial Oil Co.  
 Farm Name Keith "B" No. 5

TOPS	DEPTH	LOG	DATUM	Loc. in Sec.
Anh.	2120			C W/2 NW
Top				
H.	3723			
Tf.	3748			
Dg.				
Bl.				
L.	3761			
K.C.				Geol.
B.M.C.				Contr.
Ce.				Horns-Burt
C.				Pool
M.				Holley
M.				
K.				
Mz.				
Mo.				
V.				
S.				
S.				
A.				
R.				
PE.				
G.				
TD	3970			

JUL 31 57  
 COMPLETE

Date Comm. 5-29-57  
8" @ 221/175, Drilc. 3365 JUN 12 57 5 1/2  
3970 / 100 JUN 19 57 ca 28 / 3920-24  
18 5 Goph no/w 4 hrs 1/2  
8 3 1/2 Boph no/w 8 hrs  
13 8 13 Boph no/w 8 hrs  
Pop JUN 26 57 JUL 3 57 JUL 10 57 JUL 17 57 JUL 24 57  
JUL 31 57 Ph P. 248 Boph 6 1/2 wtr  
9.11 39.3°