


Graham

KANSAS

SECTION 32 TOWNSHIP 8 RANGE 24W

WELL NO. #5 Keith "A"

COMPANY Francis Oil & Gas & H. Kaiser

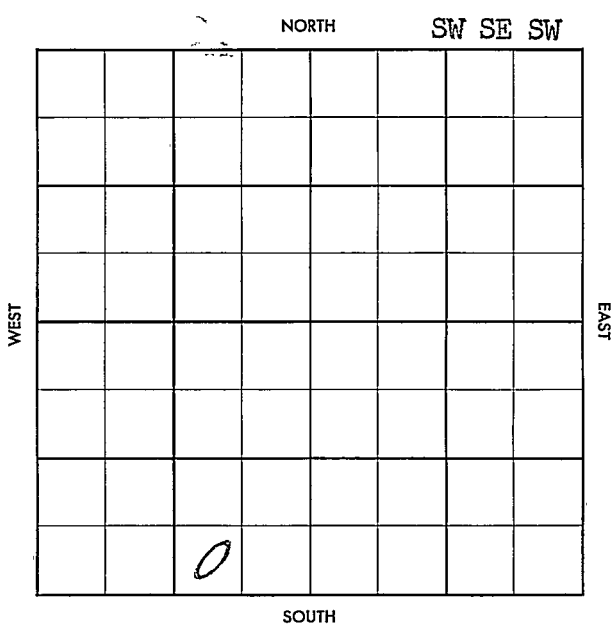

14

County Graham Elev. 2403 DF  
 Sec. 32 Twp. 8 Rgs. 24W  
 Company Francis Oil & Gas & H. Kaiser  
 FarmName Keith "A" No. 5

Co.

TOPS	DEPTH	LOG	DATUM
Anh.			
Tr.			
H.			
Tr.			
Dg.			
Bl.			
L.			
K.C.			
B.K.C.			
Ce.			
C.			
M.			
M.			
K.			
Mz.			
Me.			
V.			
S.			
S.			
A.			
R.			
Pe.			
G.			
TD.			

Loc. in Sec. SW SE SW  
 Geol. \_\_\_\_\_  
 Contr. K & E. Drlg.  
 Pool Hollow

Loc.

FIRST REPORT		
	5	57

No.

Date Comm. 5-30-57  
8" @ 203/160, Drlg. 3400

Sec.

T.

R.

*(Handwritten signature/initials)*

County Graham Elev. 2403 DF  
 Sec. 32 Twp. 8 Rge. 24W  
 Company Francis Oil & Gas & H. Kaiser  
 FarmName Keith "A" No. 5

TOPS/	DEPTH	LOG	DATUM	Loc. in Sec.
Anb. /				SW SE SW
Tr.				
H.	3692			
Tr.	3718			
Dg.				
Bl.				
L.	3734			
K.C.				Geol.
B.K.C.	3962			Contr.
Ce.				K & E. Drlg.
C.				
M.				Pool
M.				Holley
K.				
Mz.				
Mo.				
V.				
S.				
S.				
A.				
R.				
PE.				
G.				
TD.	4010			

COMPLETE  
 JUL 17 '57  
 0

Date Comm. 5-30-57

8" @ 203/160, Drlg. 3400 " " " 57  
 Pipe set JUN 19 '57 ✓ DST 3754  
 -76 1hr rec 15' Md BHP 680  
 DST 3770-95 1hr rec 15' Md  
 BHP 0 DST 3792-3805 1hr  
 rec 50' Md BHP 0 DST  
 3852-75 1hr rec 10' Md  
 BHP 0 DST 3875-98 1hr  
 400 GIP rec 30' 0 E' 6 CM + 30'

HOE 6CM + 150 50CM  
 BHP 250 DIST 3907-23  
 1hr see 10' Md BHP 0  
 DIST 3917-55 1hr see 60'  
 50CM + 60' HD CM FP 0  
 BHP 224 5 1/2 4010/150  
 MICT 16/ 3887-91 1/2 1/2  
 10 Boph no/w 8 hrs Pat  
 JUL 17 57 JUL 17 Ph P. 181 Bopd  
 no/wt 9 hrs 40°