
Graham KANSAS

SECTION 32 TOWNSHIP 8 RANGE 23W

WELL NO. #1 Wilson "K"

COMPANY CRA & Ted Gore

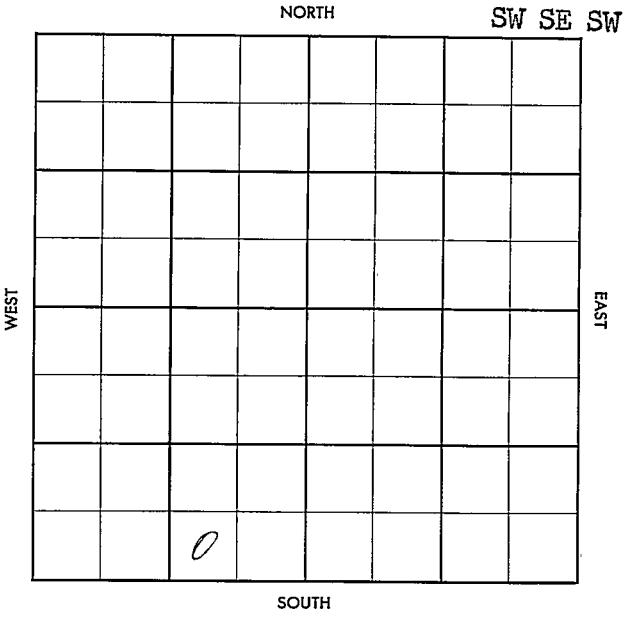

FORM 504-3 SUNRAY

FORM 513 SUNRAY

WILDCAT

County Graham Elev.

Sec. 32 Twp. 8 Rge. 23W

Company C R A & Ted Gore

Farm Name Wilson "K" No. 1


TOPS	DEPTH	LOG	DATUM
Anh.			
Tp.			
H.			
Tr.			
Dg.			
B.L.			
L.			
K.C.			
B.K.C.			
Ce.			
C.			
M.			
M.			
K.			
Mz.			
Mq.			
V.			
S.			
S.			
A			
R.			
P€.			
G.			
T.D.			

Loc. in Sec. SW SE SW

Geol.

Contr. C R A

Pool Wildcat

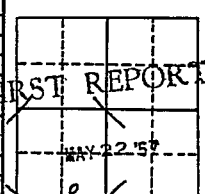

Imperial - DHM

Date Comm.

M I R

FORM 513 SUNRAY

County Graham Elev. 2358 Co.

Sec. 32 Twp. 8 Rge. 23W

Company C R A & Ted Gore

Farm Name Wilson "K" No. 1

TOPS	DEPTH	LOG	DATUM
Anh.	2020		
Tp.			
H.	3648		
Tr.	3674		
Dg.			
Bl.			
L.	3692		
K.C.			
B.K.C.		3910	
Ce.			
C.			
M.			
M.			
K.			
Mz.			
Mo.			
V.			
S.			
S.			
A			
R.			
P€.			
G.			
TD	3925		

Loc. in Sec. SW SE SW

Geol.

Contr. C R A

Lse. Broshears NW Pool Wildcat

COMPLETE SEP 11 '57

Imperial - DHM

Date Comm.

M I R MAY 29 '57 5-24-57. 85/8 224 1175 RD 3455 JUN 5 '57 DST 3762-76 1hr 120' SO & GCWM + 360' wtr BHP 1306/20" DST 3811-32 1hr 120' HGC oily Md + 60' VHO & GCM + 60' HGCMO + TR wtr + 10' GCO BHP 956/20" DST 3834-50 1hr 15' Md 2# press 0 DST 3865-90 1hr

Sec. T. R.

FORM 513-1 SUNRAY

105' WCM + 550 BHP 1075/20"
5½ 3924½/175 JUN 12 '57 CO 3899½
PF 3880-84 B 500 gal oil
+24 GWPH 55 gal. Acid
B 4 60 + 18 GWPH ½
S AV. ¼ BO + 4¾ BWPH
16 hrs PB 3851 18/
3818-21 B 5 60 + 13
GW in 30" ½ S AV. 3,48
BO + 6.21 BWPH 12 hrs
JUN 19 '57 S 19 BO + 82
BW 9 hrs S 3,49 BO
+ 10,78 BWPH 8 hrs TEK
JUN 25 '57 P. no oil + 89 BW
in 11 hrs JUL 3 '57 P. 30.16
BO + 110 BW 24 hrs JUL 10 '57
JUL 17 '57 JUL 24 '57 P. 41 BO + 105 BW
24 hrs JUL 31 '57 P. 36 BO + 106
BW 24 hrs AUG 8 '57 AUG 14 '57 P. 15
BO + 51 BW in 18 hrs AUG 21 '57
PB 34.86 BO + 75% W/24 hrs AUG 28 '57
P 33 BO + 100 BW 24 hrs
4 P. 36 BO + 25% W
24 hrs SEP 11 '57 36 BOPD + 73%
W 38°

32-8-23W