

Rooks

KANSAS



Sec. 32 Twp. 8 R. 19W

Well No. #1 John Osdrasek Farm

Deep Rock


Hayden Pool (Heathman & Honaker) NORTH Company

_____ Ft. from N. Line

330' Ft. from S. Line

_____ Ft. from E. Line

330' Ft. from W. Line

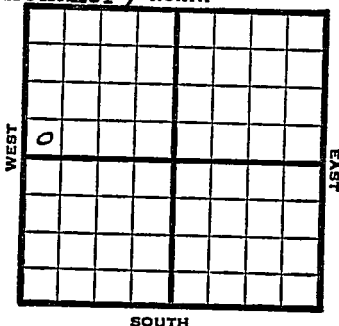

SW NW

1949 Elev 2044' REPORT

6/29	Anhy. 1508' 8" @ 1517'
7/6	"
7/12	Lansing 3240' Arb. 3486'-89' ED 3489' 5" @ 3487'
7/20	TD 3493' 1150 Acid Swb 32 bbls oil 1 hr
7/27	1150 acid Swb 32 bbls oil 1 hr
8/3	"
8/10	"
8/24	TD 3489' Arb. 3492' 5" @ 3487' 1150 acid Pump 160 oil Pot 28° Gr. Comp

COMPLETED

Map No. _____ Sec. 32 Twp. 8 R. 19W

Well No. 1 John Osdrasek

Deep Rock Company

Heathman & Honsker Contractor

SW NW

**FIRST REPORT
SECTION PLAT**

_____ Ft. from N. Line

330 Ft. from S. Line

_____ Ft. from E. Line

330 Ft. from W. Line

Rooks County

Location _____

Rig up _____

Drilling and Remarks:

Anhy 1508

8" @ 1517

RECORD

Cased _____ in., _____ ft.

Sand _____

Gas _____

Oil _____

Total Depth _____

PRODUCTION

1st 24 hrs. Nat. _____

1st 24 hrs. after shot _____

Gas _____ Cu. Ft.

Dry Hole _____

Abandoned _____

Date

JUN 29 1949

19

S. J. LEWIS

Scout

