

Rooks

KANSAS ✓
19W

Sec. 32 Twp. 8 R. 19W

Well No. #2 Oudrasek Farm

Deep Rock Company

Hayden Pool


 Ft. from N. Line

990' Ft. from S. Line

 Ft. from E. Line

990' Ft. from W. Line

NE SW NW

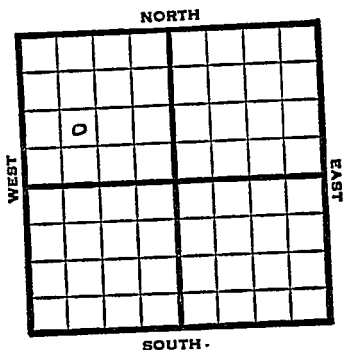

1949

Elev 2031'

REPORT

8/10

RUR

8/17

8" @ 1495'

Drlg 1969'

8/24

Lansing 3223

Arbuckle 3469-71

TD

Run 5"

8/31

5" @ 3470'

TD 3475'

Swb 24 bbls oilPH

9/7

"

9/14

TD 3475'

Arb. 3469'

5" @ 3470'

Depth Pot 3000 Oil

29° Gr.

Comp

COMPLETED

Map No. _____ Sec. 32 Twp. 8 R. 19W

Well No. 2 Oudrasek

Deep Rock Company

Heathman Drlr. Contractor

NE SW NW

**FIRST REPORT
SECTION FLAT**

_____ Ft. from N. Line

990 Ft. from S. Line

_____ Ft. from E. Line

990 Ft. from W. Line

o			

Rooks County

RECORD

Location _____

Cased _____ in., _____ ft.

Rig up _____

Sand _____

Drilling and Remarks:

Gas _____

R U R

Oil _____

Total Depth _____

PRODUCTION

1st 24 hrs. Nat. _____

1st 24 hrs. after shot _____

Gas _____ Cu. Ft.

Dry Hole _____

Abandoned _____

Date

AUG 10 1949

19

S. J. LEWIS

Scout

