

Section 32 Township 8 Range 19WWell No. #8 OndrasekCompany Deep [~]Rock

NORTH

		0					

WEST

EAST

SOUTH

'Rooks

KANSAS

Sec. 32 Twp. 8 R. 19W

Well No. #8 Ondrasek Farm

Deep Rock

Company

Hayden Pool

Contractor

Ft. from N. Line

990'


Ft. from S. Line

990'

Ft. from E. Line

Ft. from W. Line

NW SE NW

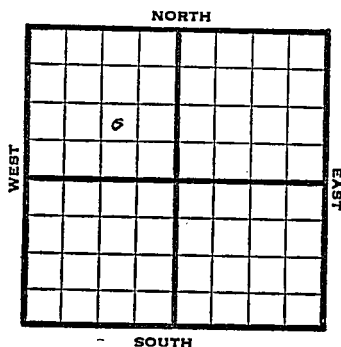

1950

Elev. 2040'

REPORT

12/6

Location

1951

1/24

Spud 12-8-50

Oil Well TD 3491

10" @ 125' Heeb. 3202

KC 3241'

DST 3258-85 opn 45 min

Rec. 15' mud

2' free oil DST 3356-85 opn 1 hr

Rec. 75' ocm DST 3385-3405 opn

1 hr Rec. 1260' free oil 60' ocm

Arb. 3489-91 7" @ 3489


60/3390-3402 10 goph 500 A

s/11 boph Comp. 180 bopd

COMPLETED

J. E. TYRA

County _____ Rocks _____ State Kansas
 Sec. 32 (Blk. Twp.) 8 (Sur. Rge.) 19W Map No. _____
 Operator Deep Rock
 Well No. 8 Farm Ondrasek
 Elev. 2040 Location NW SE NW

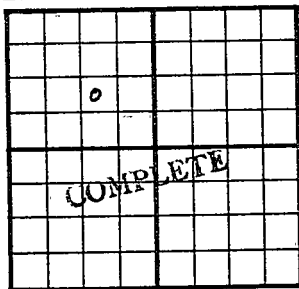

990 Ft. From S Line NW
 990 Ft. From E Line Quarter

1st. Report _____

Completion JAN 24 1951

Remarks Hayden Pool

Spudding Date 12-8-50

Drlg. Data Oil well TD 3491

10" @ 125 Heeb. 3202 KC 3241

DST 3258-85 open 45 min. Rec. 15' mud

2' free oil DST 3356-85 open 1 hr.

Rec. 75' ocm DST 3385-3405 open 1 hr.

Rec. 1260' free oil 60' ocm Arb. 3489-91

7" @ 3489 60/ 3390-3402 10 goph 500 A

S/ 11 boph Comp. 180 bopd

J. E. TYRA