


Section 32 Township 8 Range 19W

Well No. #9¹⁰ Ondrasek

Company Deep Rock

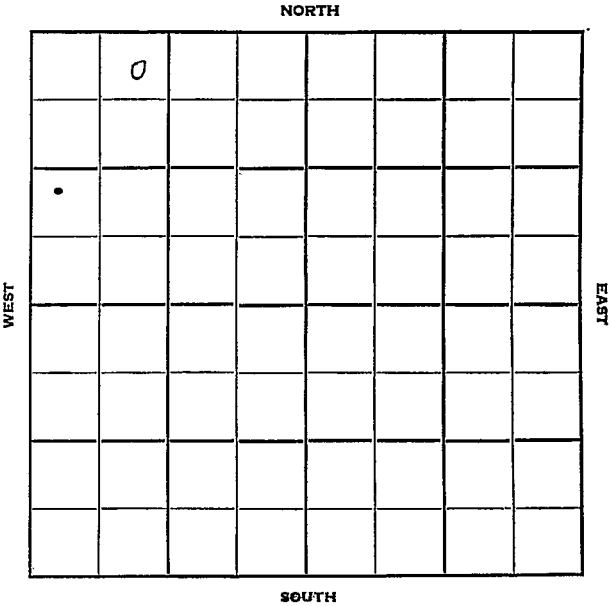

Róoks

KANSAS
19W

Sec. 32 Twp. 8 R. 19W

Well No. #9 ~~#10~~ Ondrasek Farm

Deep Rock

Company

Hayden Pool

Contractor


330' Ft. from N. Line

Ft. from S. Line

Ft. from E. Line

990' Ft. from W. Line

NE NW NW

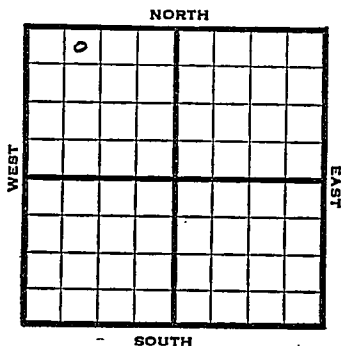

1950

Elev. 2041' REPORT

12/6

Location

1951

1/17

Aband. Location

ABANDONED

Kansas

Map No. _____ Sec. 32 Twp. 8 R. 19WWell No. 10 Ondrasek

Deep Rock

Company

CORRECTION

Contractor

NE NW NW

SECTION PLAT

330 Ft. from N. Line

_____ Ft. from S. Line

_____ Ft. from E. Line

990 Ft. from W. Line

Rooks County

Location _____

Rig up _____

Drilling and Remarks:

Reported

#9 Ondrasek

RECORD

Cased _____ in., _____ ft.

Sand _____

Gas _____

Oil _____

Total Depth _____

PRODUCTION

✓ 1st 24 hrs. Nat. _____

✓ 1st 24 hrs. after shot _____

Gas _____ Cu. Ft.

Dry Hole _____

Abandoned _____

Date

DEC 27 1950 19

J. E. TYRA

Scout

County Rooks State Kansas

Sec. 32 (Blk. Twp.) 8 (Sur. Rge.) 19W Map No.

Operator Deep Rock

Well No. 9 Farm Ondrasek

Elev. 2041 Location NE NW NW

0					

FIRST REPORT

330 Ft. From N Line NW

990 Ft. From W Line Quarter

1st. Report DEC 6 1950

Completion

Remarks

Spudding Date

Drlg. Data Hayden Pool
Location

County Rooks State Kansas

Sec. 32 (Blk. Twp.) 8 (Sur. Rge.) 19W Map No.

Operator Deep Rock

Well No. 10 Farm Ondrasek

Elev.	2041	Location	NE NW NW
-------	------	----------	----------

330 Ft. From N Line NW

990 Ft. From W Line Quarter

1st. Report

Completion JAN 17 1951

Remarks Hayden Pool

Spudding Date _____

Drlg. Data

Location abd.

J. E. TYRA