

# KANSAS

Rooks

Section 32 Township 8 Range 19W

Well No. 1 Swalp

Company Cities Service

Hayden

NORTH

WEST

EAST

0					1		

SOUTH

Sec. 32 Twp. 8 R. 19W

Well No. #1 Swalp Farm

Cities Service

Company

Hayden Pool


330' Ft. from N. Line

\_\_\_\_\_ Ft. from S. Line

\_\_\_\_\_ Ft. from E. Line

330' Ft. from W. Line

NW SW

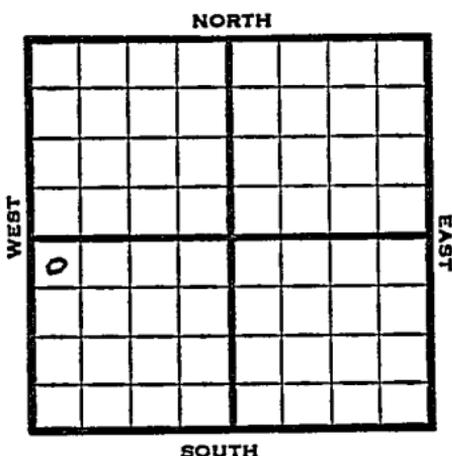

1949

Elev 2057' REPORT

8/31

Drlg. 640'

9/7

8" @ 1529'  
Drlg. 1860'

9/14

TD 3592'  
Lansing 3266'  
Arb. 3560'  
Aband.

**ABANDONED**

Kansas

Map No. \_\_\_\_\_ Sec. 32 Twp. 8 R. 19W

Well No. 1 Swalp

Cities Service

Company

Contractor

NW SW

FIRST REPORT SECTION PLAT

330 Ft. from N. Line

Ft. from S. Line

Ft. from E. Line

330 Ft. from W. Line

o			

Rooks County

RECORD

Location \_\_\_\_\_

Cased \_\_\_\_\_ in., \_\_\_\_\_ ft.

Rig up \_\_\_\_\_

Sand \_\_\_\_\_

Drilling and Remarks:

Gas \_\_\_\_\_

drlg. 640

Oil \_\_\_\_\_

Total Depth \_\_\_\_\_

PRODUCTION

1st 24 hrs. Nat. \_\_\_\_\_

1st 24 hrs. after shot \_\_\_\_\_

Gas \_\_\_\_\_ Cu. Ft.

Dry Hole \_\_\_\_\_

Abandoned \_\_\_\_\_

Date

AUG 31 1949 19

S. J. LEWIS Scout

Kansas

Map No. K65 Sec. 32 Twp. 8 R. 19W

Well No. 1 Swalp

Cities Service Company

**ABANDONED**

Contractor

NW SW

*E1.2057*  
SECTION PLAT

330 Ft. from N. Line

         Ft. from S. Line

         Ft. from E. Line

330 Ft. from W. Line

0			

Rooks County

Location \_\_\_\_\_

Rig up \_\_\_\_\_

Drilling and Remarks:

*Home 3266*

*Cr 73560*

**RECORD**

Cased \_\_\_\_\_ in., \_\_\_\_\_ ft.

Sand \_\_\_\_\_

Gas \_\_\_\_\_

Oil \_\_\_\_\_

Total Depth 3092

**PRODUCTION**

1st 24 hrs. Nat. \_\_\_\_\_

1st 24 hrs. after shot \_\_\_\_\_

Gas ✓ \_\_\_\_\_ Cu. Ft.

Dry Hole \_\_\_\_\_

Abandoned \_\_\_\_\_

Date

SEP 14 1949

19

**S. J. LEWIS**

Scout