


Rooks **KANSAS**

SECTION 32 TOWNSHIP 8 S RANGE 19 W

WELL NO. # 2 Wines

COMPANY Grant Oil

NORTH C E/2 SW/4

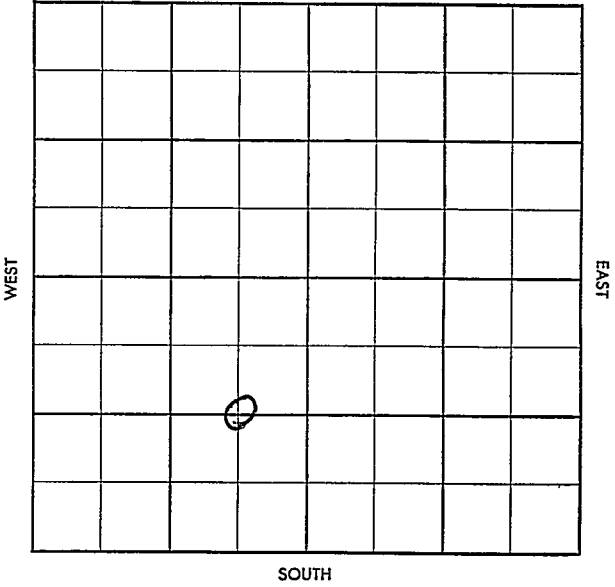

Top Pool

Bottom Facet

513

County Rooks Elev. 2070 D.F.

Sec. 32 Twp. 8 Rge. 19W

Company Grant Oil

Farm Name Wines No. 2

TOPS	DEPTH	LOG	DATUM
Anh.	1524		
Top	3250		
H.	3257		
T.			
Dol.			
B.			
L.	3297		
K.C.			
B.K.C.	3310		
C.E.			
C.	3543		
M.			
M.			
K.			
Mz.			
Mb.			
V.			
S.			
S.			
A.			
R.			
PF.			
G.			
T.D.	3573		

Loc. in Sec. _____

0 1/2 SW/4

660' EE

1320' SL

Geol. _____

Contr. _____

Murfin Drlg

Pool _____

Hayden

ABANDONED

SEP 24 58

0

Date/Comp. 9-12-58

8" @ 209/150. drlg. 2520 SEP 24 58

No Log

D.A.

Co.

No.

Sec.

T.

R.