


Graham

Section 32 Township 8 Range 21W

Well No. #1 Green

Company Nadel & Gussman

NORTH

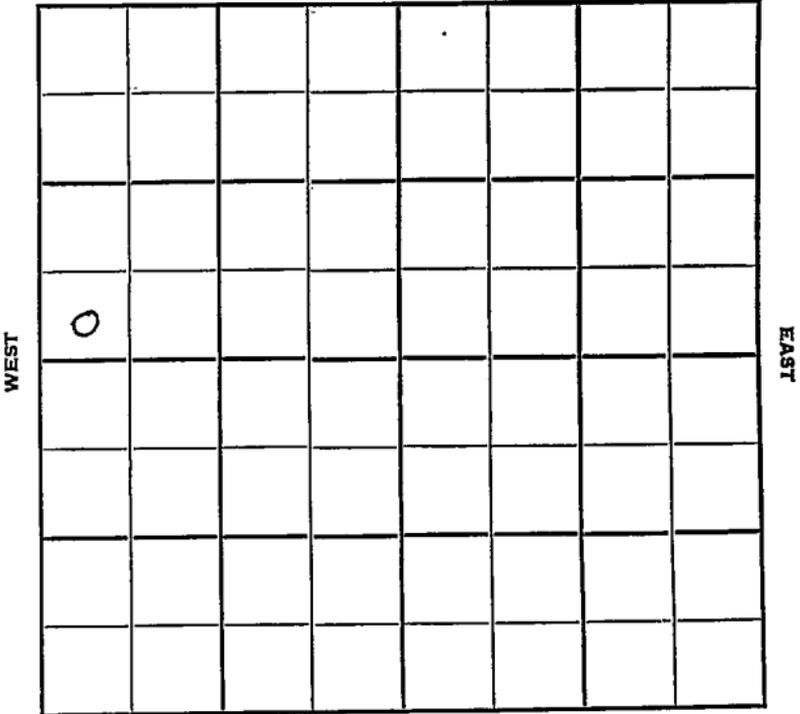

SOUTH

WEST

EAST

Sec. 32 Twp. 8 R. 21W ✓

Well No. #1 Green Farm

Nadel & Gussman Company

Reserve Contractor


Wildcat

 Ft. from N. Line

330 Ft. from S. Line

330 Ft. from E. Line

330 Ft. from W. Line

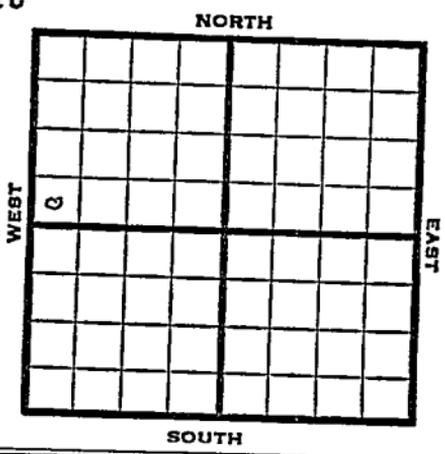

SW SW NW

Skelly-DHM

1951 Elev. 2203' REPORT

11/7

Spud 11-2-51
8" @ 169'
Anhy 1740-75
Drlg. 2500'

11/14

Spud 11-2-51
D & A TD 3782' 8" @ 169'
Anhy 1740-75' Heeb 3380' Tor 3401'
Lans. 3419'
DST 3410-28 open 20 min. rec 600' SW
Arb. 3766'
DST 3769-73 open 1 hr. rec 140' SW
TD 3782'
D & A

ABANDONED

Handwritten scribble

County Graham State Kansas

Sec. 32 (Blk. Twp.) 8 (Sur. Rge.) 21W Map No.

Operator Nadel & Gussman

Well No. 1 Farm Green

Elev. _____ Location SW SW NW

FIRST REPORT											

330 Ft. From S Line NW

330 Ft. From W Line Quarter

Ist. Report NOV 7 1951

Completion _____

Remarks Skelly - DM

Reserve - Contr.

Spudding Date 11-2-51

Drlg. Data Wildcat

8" @ 169' Anhy 1740-75 Drlg. 2500

J. E. TYRA

