


Section 32 Township 8 Range 26 W

Well No. # 1 Pratt

Company Anderson-Prichard

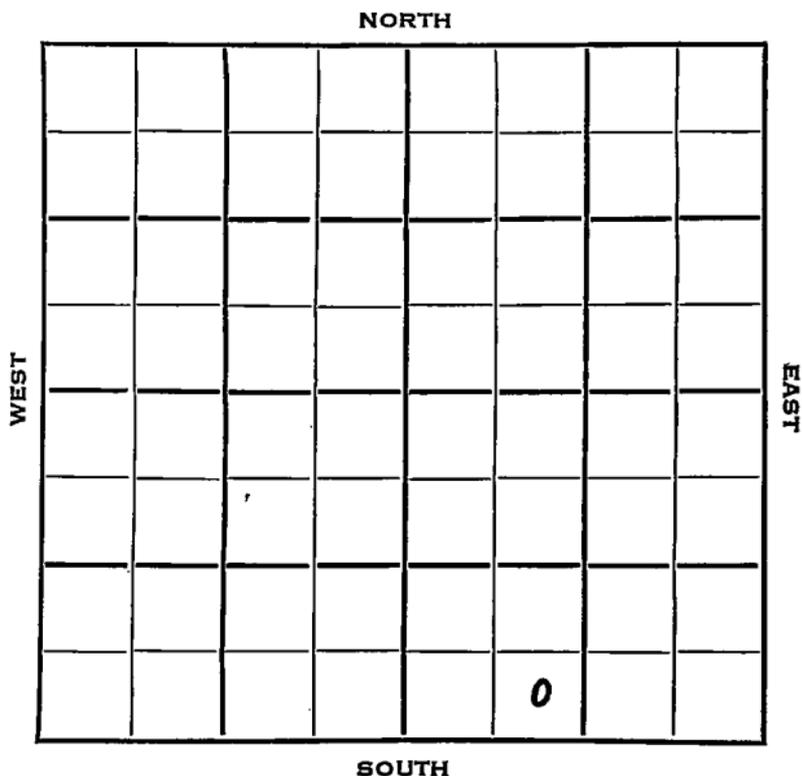

15

Sheridan

KANSAS

|      |      |     |
|------|------|-----|
| SEC. | TWP. | R.  |
| 32   | 8    | 26W |

WELL-NO. #1 Pratt FARM

COMPANY Anderson-Prichard

CONTRACTOR

Semi Wildcat


\_\_\_\_\_ Ft. from N. Line

330 \_\_\_\_\_ Ft. from S. Line

\_\_\_\_\_ Ft. from E. Line

990 \_\_\_\_\_ Ft. from W. Line

SE SW SE

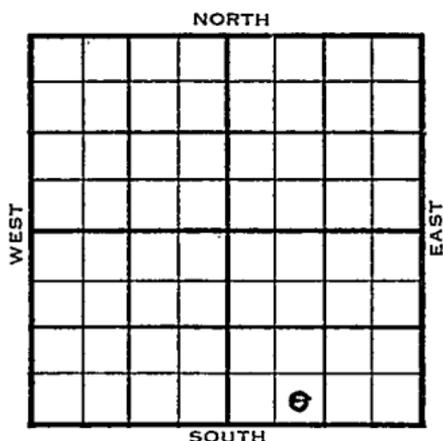

|      |                 |        |
|------|-----------------|--------|
| 1953 | ELEVATION 2574' | REPORT |
|------|-----------------|--------|

9/9 Location  
 9/16 8" @ 245  
 Drlg. 3019'  
 9/23 Spud 9-10-53  
 D&A  
 TD 4350'  
 8" @ 245'  
 Heeb 3663', Tor 3683', Lans 3698'  
 DST 3736-70', opn 1 hr., rec. 15'  
 hocm, 60' mcsw, 1170#  
 DST 3774-3802', opn 1/2 hrs., rec. 6'  
 mud, 65#  
 DST 3818-40, opn 1 hr., rec. 20'  
 wcm, 5' oil, 935#  
 DST 3882-3902', opn 1/2 hrs., rec. 3'  
 mud & VSSO; 35#  
 B KC 3924', Cong 4226', Miss 4250',  
 Arb. 4317'  
 TD 4350'  
 D&A

ABANDONED



