


Section 33 Township 8 Range 16W

Well No. 2 Adams "C"

Company Cities Service

Laton Pool  
NORTH

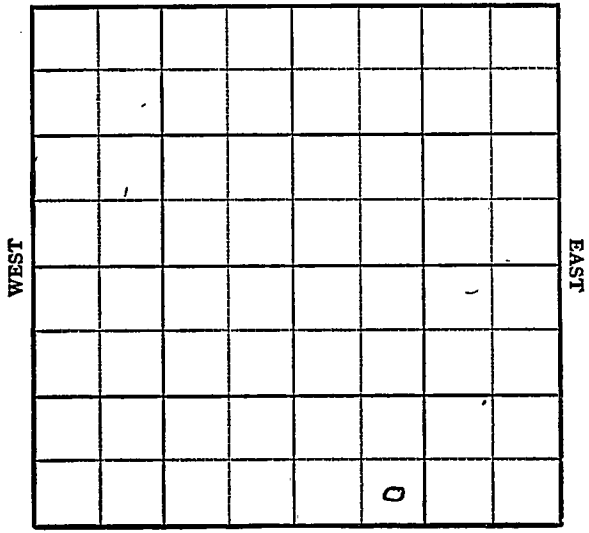

SOUTH

KANSAS

Rooks.

Sec. 33 Twp. 8 R. 16W ✓

Well No. #2 Adams "C" Farm \_\_\_\_\_

Cities Service Company \_\_\_\_\_

Laton Pool


\_\_\_\_\_ Ft. from N. Line

330' Ft. from S. Line

\_\_\_\_\_ Ft. from E. Line

990' Ft. from W. Line

SE SW SE

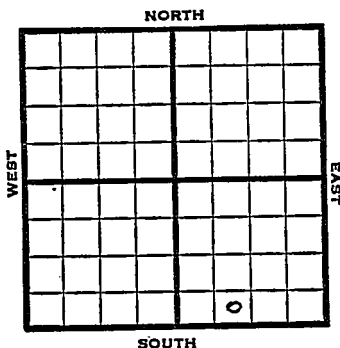

1948

Eli 1966' REPORT

12/15  
12/22

8" @ 249'  
Lansing 3073'  
TD 3310  
4" @ 3310'

12/29  
1949

"  
TD 3310  
Lansing 3073'  
4" @ 3310'  
Perf 5000 acid  
Pump 80 oil / 122 Water Pot  
28<sup>0</sup> Gr.

1/12

Comp  
**COMPLETED**

Map No. \_\_\_\_\_ Sec. 33 Twp. 8 R. 16W

Well No. 2 Adams "C"

Cities Service Company

**FIRST REPORT** Contractor

SE SW SE

**SECTION PLAT**

\_\_\_\_\_ Ft. from N. Line

330 Ft. from S. Line

\_\_\_\_\_ Ft. from E. Line

990 Ft. from W. Line


Rooks County

Location \_\_\_\_\_

Rig up \_\_\_\_\_

Drilling and Remarks:

8" @ 249

**RECORD**

Cased \_\_\_\_\_ in., \_\_\_\_\_ ft.

Sand \_\_\_\_\_

Gas \_\_\_\_\_

Oil \_\_\_\_\_

Total Depth \_\_\_\_\_

**PRODUCTION**

1st 24 hrs. Nat. \_\_\_\_\_

1st 24 hrs. after shot \_\_\_\_\_

Gas \_\_\_\_\_ Cu. Ft.

Dry Hole \_\_\_\_\_

Abandoned \_\_\_\_\_

Date

DEC 15 1948

19

S. J. LEWIS

Scout

