


**KANSAS**  
FORM 51 IOM 12-46 PETROL

Section 33 Township 8 Range 16-W

Well No. #1 Adams "C"

Company Cities Service  
Iaton

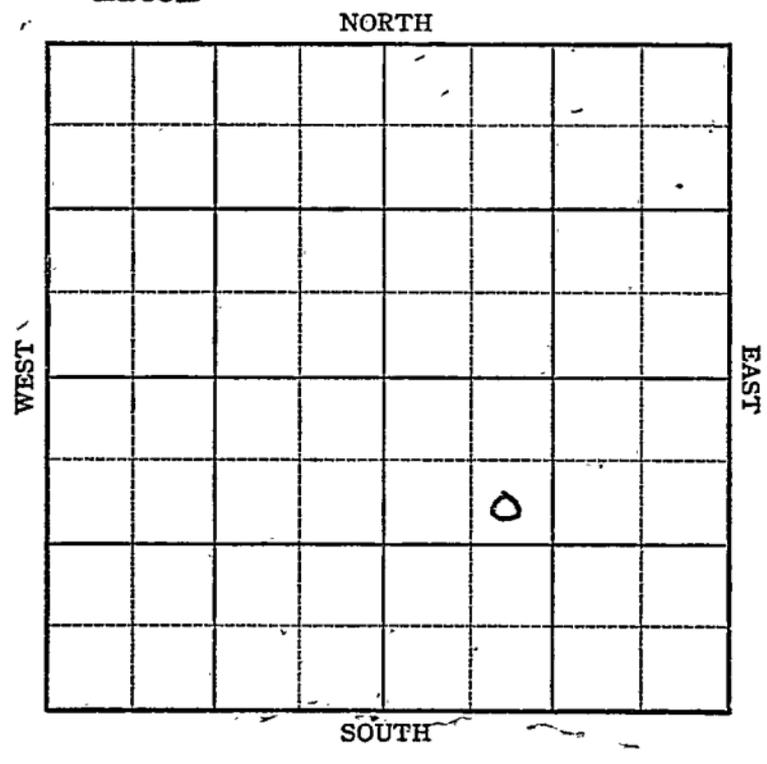

Sec. 33 Twp. 8 R. 16-W

Well No. # 1 Adams "C" Farm

Cities Service Company


Laton

990 Ft. from N. Line

\_\_\_\_\_ Ft. from S. Line

\_\_\_\_\_ Ft. from E. Line

990 Ft. from W. Line

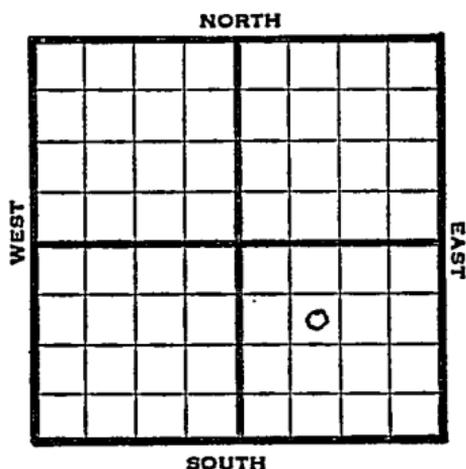

SE NW SE

1947 Elev. 1951' REPORT

6/18 8" @ 220' WOC

6/24 Drlg 2685'

7/1 Lansing 3070'  
TD 3295'  
4" @ 3295'  
RUST

7/8 "

7-16 "

7/22 "

7/29 31 shots. 3144-52'  
28 shots. 3128-33'  
38 shots. 3106-16'  
15 shots. 3095-3101'  
16 shots. 3068-73'  
130' W in 4 hrs., SSO

8/6 5000 Acid  
Swab 33 bbls oil / 19 W in 24 hrs.

8/13 "

8/20 "

8/27 "

9/3 "

9/10 "

OVER

1947

9/17 33 bbls. oil & 19 W 24 hrs.

9/24 " "

, 10/1 Lansing 3070'  
4" @ 3295  
Perf 500 acid  
Pump 32 oil & 18 wtr.  
TD 3295  
Grav. 26

**COMPLETED**

•  
•  
•  
•  
•

Map No. \_\_\_\_\_ Sec. 33 Twp. 8 R. 16W

Well No. 1 Adams "C"

Cities Service Company

**FIRST REPORT** Contractor \_\_\_\_\_

SE NW SE


**SECTION PLAT**

990 Ft. from N. Line

\_\_\_\_\_ Ft. from S. Line

\_\_\_\_\_ Ft. from E. Line

990 Ft. from W. Line

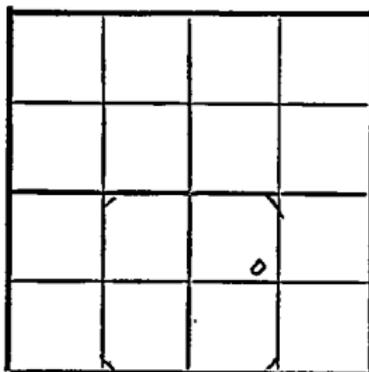

Rooks County

Location \_\_\_\_\_

Rig up \_\_\_\_\_

Drilling and Remarks:

8" @ 220 WOC

**RECORD**

Cased \_\_\_\_\_ in., \_\_\_\_\_ ft.

Sand \_\_\_\_\_

Gas \_\_\_\_\_

Oil \_\_\_\_\_

Total Depth \_\_\_\_\_

**PRODUCTION**

1st 24 hrs. Nat. \_\_\_\_\_

1st 24 hrs. after shot \_\_\_\_\_

Gas \_\_\_\_\_ Cu. Ft.

Dry Hole \_\_\_\_\_

Abandoned \_\_\_\_\_

Date

JUN 1 8 1947 19 \_\_\_\_\_ S. J. LEWIS Scout

