



Sec. 33 Twp. 8 R. 16W

Well No. #2 Bergier Farm \_\_\_\_\_


Lion Oil Company  
Laton

990 Ft. from N. Line

\_\_\_\_\_ Ft. from S. Line

990 Ft. from E. Line

\_\_\_\_\_ Ft. from W. Line

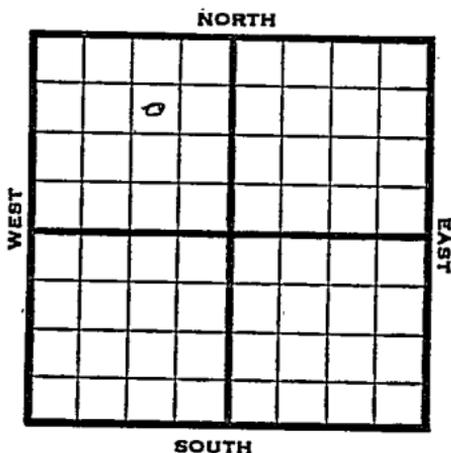

SW NE NW

1948 Elev. 1971' REPORT

- 4/7 RUR
- 4/14 8" @ 180'  
Lansing 3099'  
Drlg. 3240'
- 4/21 TD 3331'  
Run csg.
- 4/28 5½" @ 3330'  
25 shots 3309-14' 1000 acid 3 gals oil  
PH Plug 3302'  
36 shots 3282-90'  
48 shots 3257-65'  
4000 acid Pump 6 bbls. oil 1½ hrs.
- 5/7 Pump 8 fluid PH 24 hrs. 76% water.
- 5/12 "
- 5/19 "
- 5/26 "
- 6/1 "
- 6/9 Lans. 3099'  
5" @ 3330'  
Perf. 5000 acid  
Pump 16 oil / 32 W pot  
Gr. 27.0  
TD 3331'  
Comp.

COMPLETED

Map No. \_\_\_\_\_ Sec. 33 Twp. 8 R. 16W

Well No. 2 Bergier

Lion Oil Company

### FIRST REPORT

Contractor \_\_\_\_\_

SW NE NW

#### SECTION PLAT

	o		

990 Ft. from N. Line

\_\_\_\_\_ Ft. from S. Line

990 Ft. from E. Line

\_\_\_\_\_ Ft. from W. Line

Rooks County

Location \_\_\_\_\_

Rig up \_\_\_\_\_

Drilling and Remarks:

R U R

#### RECORD

Cased \_\_\_\_\_ in., \_\_\_\_\_ ft.

Sand \_\_\_\_\_

Gas \_\_\_\_\_

Oil \_\_\_\_\_

Total Depth \_\_\_\_\_

#### PRODUCTION

1st 24 hrs. Nat. \_\_\_\_\_

1st 24 hrs. after shot \_\_\_\_\_

Gas \_\_\_\_\_ Cu. Ft.

Dry Hole \_\_\_\_\_

Abandoned \_\_\_\_\_

Date

APR 7 1948 19\_\_\_\_\_

S. J. LEWIS Scout

