FORM 51 10M 8-47


KANSAS

Rooks

Section 33 Township 8 Range 16-W

Well No. #4 Bergier

Company Lion Oil

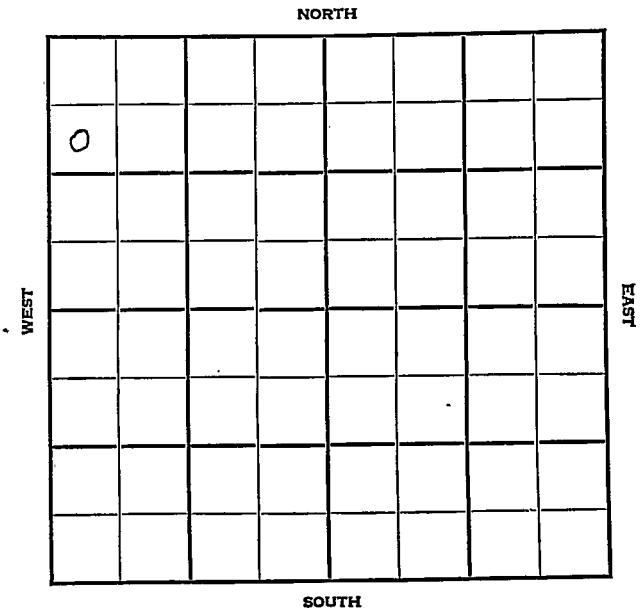

FORM 252-A
5M 4-48 PETROL

KANSAS

Rooks

Sec. 33 Twp. 8 R. 16W

Well No. #4 Bergier Farm

Lion Oil Company

Laton Pool


990' Ft. from N. Line

Ft. from S. Line

Ft. from E. Line

330' Ft. from W. Line

SW NW NW

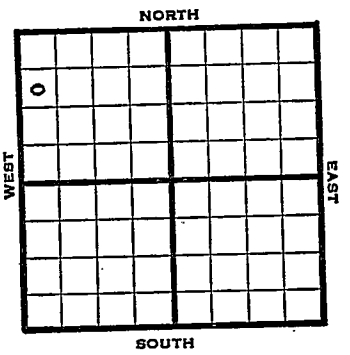

1948	Elev. 1968' REPORT
5/5	8" @ 189' WOC
5/12	Lansing 3103' TD 3357' 5" @ 3356' RUST
5/19	Plug 3160' 18 shots 3141-47 6 " 3103-05 1000 acid
5/26	Lans. 3103' TD 3357' ABANDONED

Form 26—200 Bks.—1-48—Palace

Kansas

Laton Pool

Map No.____ Sec. 33 Twp. 8 R. 16W

Well No. 4 Bergier

Lion Oil Company

FIRST REPORT Contractor

SW NW NW


990 Ft. from N. Line

____ Ft. from S. Line

____ Ft. from E. Line

330 Ft. from W. Line

SECTION PLAT

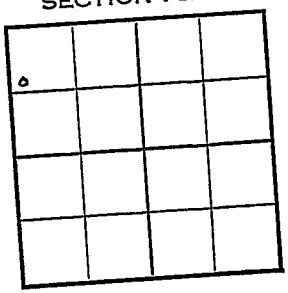

Rooks County

Location

Rig up

Drilling and Remarks:

8"@ 189 WOC

RECORD

Cased ____ in., ____ ft.

Sand

Gas

Oil

Total Depth

PRODUCTION

1st 24 hrs. Nat.

1st 24 hrs. after shot

Gas ____ Cu. Ft.

Dry Hole

Abandoned

Date

MAY 5 1948 19____ S. J. LEWIS Scout

Form 26—200 Bks.—1-48—Palace

Kansas

Laton Pool

Map No. 64 Sec. 33 Twp. 8 R. 16W

Well No. 4 Bergier

Lion Oil Company


ABANDONED

Contractor

E.1.1968

SW NW NW

SECTION PLAT

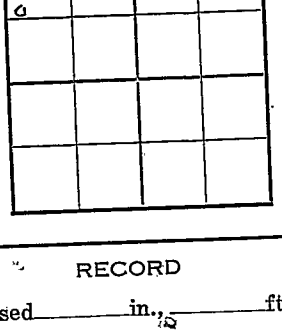

990 Ft. from N. Line

Ft. from S. Line

Ft. from E. Line

990 Ft. from W. Line

Rooks County

Location

Rig up

Drilling and Remarks:

Lans 8103

RECORD

Cased in., ft.

Sand

Gas

Oil

Total Depth 3357

PRODUCTION

1st 24 hrs. Nat.

1st 24 hrs. after shot

Gas Cu. Ft.

Dry Hole

Abandoned

Date

MAY 26 1948 19

S. J. LEWIS Scout