


Section 33 Township 8 Range 16W

Well No. #3 Bergier

Company Lion Oil  
Laton Pool

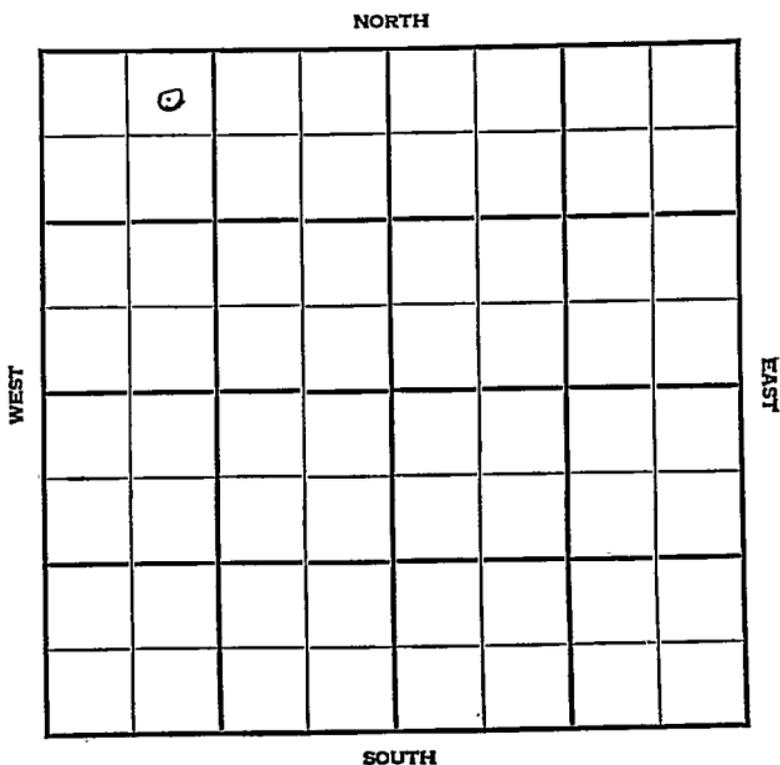

KANSAS

Rooks County

Sec. 33 Twp. 8 R. 16W

Well No. #3 Bergier Farm


Lion Oil Co. Company

330' Latin Pool  
Ft. from N. Line

Ft. from S. Line

Ft. from E. Line

990' Ft. from W. Line

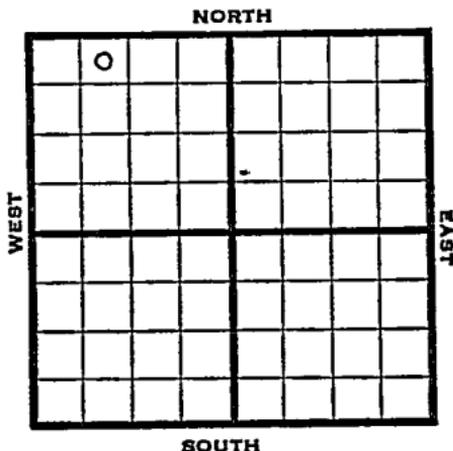

NE NW NW

1948

Elev. 1947' REPORT

- 4/21 8" @ 191'  
WOC
- 4/28 Lansing 3069'  
TD 3321'  
5" @ 3320'  
RUST
- 5/5 Lans. 3069'  
5 1/2" @ 3320'  
Perf  
3000 Acid  
Pump 50 oil P.o.t.  
Gr. 27°  
TD 3321'

**COMPLETED**

Map No. \_\_\_\_\_ Sec. 33 Twp. 8 R. 16W

Well No. 3 Bergier

Lion Oil Company

**FIRST REPORT**

Contractor \_\_\_\_\_

NE NW NW

**SECTION PLAT**

330 Ft. from N. Line

\_\_\_\_\_ Ft. from S. Line

\_\_\_\_\_ Ft. from E. Line

990 Ft. from W. Line

0			

Rooks County

Location \_\_\_\_\_

Rig up \_\_\_\_\_

Drilling and Remarks:

8" @ 191 WOC

**RECORD**

Cased \_\_\_\_\_ in., \_\_\_\_\_ ft.

Sand \_\_\_\_\_

Gas \_\_\_\_\_

Oil \_\_\_\_\_

Total Depth \_\_\_\_\_

**PRODUCTION**

1st 24 hrs. Nat. \_\_\_\_\_

1st 24 hrs. after shot \_\_\_\_\_

Gas \_\_\_\_\_ Cu. Ft.

Dry Hole \_\_\_\_\_

Abandoned \_\_\_\_\_

Date

APR 21 1948

19

S. J. LEWIS

Scout

