


Section 33 Township 8 Range 24 W

Well No. #2 Brown "D"

Company Imperial Drlg.

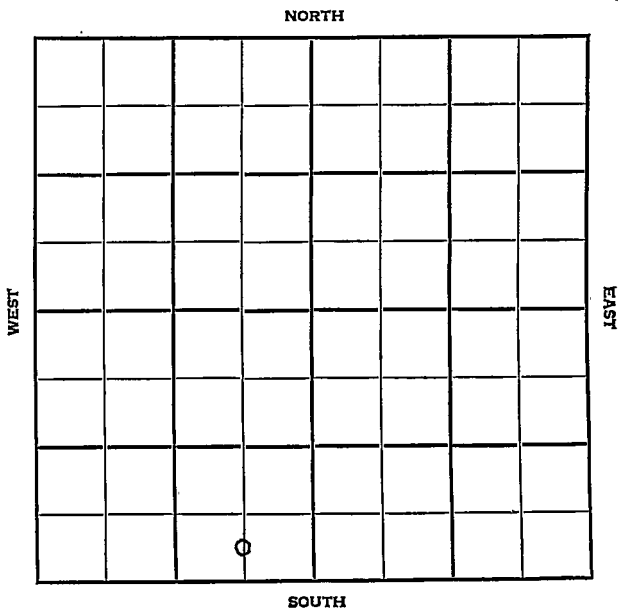

14

## Graham

KANSAS

SEC.

33

TWP.

8

R.

24W

WELL NO.

#2 Brown "D"

COMPANY

Imperial Drlg.

FARM

CONTRACTOR

Co. Tools


Holly

\_\_\_\_\_ Ft. from N. Line

\_\_\_\_\_ Ft. from S. Line

\_\_\_\_\_ Ft. from E. Line

\_\_\_\_\_ Ft. from W. Line

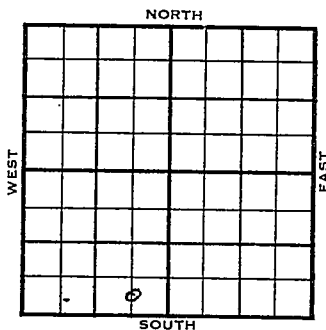C S $\frac{1}{2}$  SE SW

1955

ELEVATION

2447'

REPORT

8/24

Comm 8-19-55

8" @ 220/175

Drlg 3000

9/28

Comm 8-19-55

8" @ 220/175

Anh

2144

T H

3740

Tr

3766

L

3782

DST 3802-20 open 2 hrs Rec 900' str

1065/20" DST 3822-38 open 1 hr Rec

80' ~~str~~ oil 1125/20" DST 3929-41

op 2 hrs Rec 2000' gas 320' oil

1035/20" DST 3949-70 open 2 hr Re

20' OCM 90/20" 5 1/2" @ 4010 30/

3931-36 S/1 boph 8 hr 2000 A

S/24 $\frac{1}{2}$  boph 5 hr Comp 397 bopd

COMPLETED

County Graham Elev. \_\_\_\_\_  
 Sec. 33 Twp. 8 Rge. 24W  
 Company Imperial Drlg.  
 FarmName Brown "D" No. 2

TOPS	DEPTH	LOG	DATUM
Anb.			
Tr.			
H.			
Dg.			
Bl.			
L.			
K.C.			
B.K.C.			
Ce.			
C.			
M.			
M.			
K.			
Mz.			
Ma.			
V.			
S.			
S.			
A.			
R.			
PE.			
G.			
T.D.			

Loc. in Sec. C S  $\frac{1}{2}$  SE SW

Geol. \_\_\_\_\_

Contr. \_\_\_\_\_

Co. tools

Pool \_\_\_\_\_

Holly

AUG 24 55  
**FIRST REPORT**  
 D

Date Comm. 8-19-55  
8" @ 220/175 drlg. 3000

*[Handwritten signature]*

Co.  
 Lse.  
 No.  
 Sec.  
 T.  
 R.

County Graham Elev. 2147  
 Sec. 33 Twp. 8 Rge. 2 LW  
 Company Imperial Drlg.  
 Farm Name Brown "D" No. 2

TOPS	DEPTH	LOG	DATUM	Loc. in Sec.
Anh.	<u>2144</u>			<u>C S<math>\frac{1}{2}</math> SE SW</u>
Tp.				
H.	<u>3740</u>		<u>1293</u>	
Tr.	<u>3766</u>		<u>1319</u>	
Dg.				
Bl.				
L.	<u>3782</u>		<u>1335</u>	Geol. _____
K.C.				Contr. _____
B.K.C.				
Ce.				<u>Co. tools</u>
C.				
M.				<u>Pool</u>
M.				<u>Bolly</u>
K.				<div style="border: 1px solid black; padding: 5px; text-align: center;"> <p><b>COMPLETE</b></p> </div>
Mz.				
Me.				
V.				
S.				
S.				
A.				
R.				
Pe.				
G.				
T.D.	<u>4010</u>			

Date Comm. 8-19-55 SEP 28 1955  
8" @ 220/175 DST 3802-20 open 2 hr.  
Rec. 900' wtr. 1065/20" DST 3822-38  
open 1 hr. Rec. 80' oil 1125/20"  
DST 3929-41 open 2 hr. Rec. 2000' gas  
320' oil 1035/20" DST 3949-70 open  
2 hr. Rec. 20' ocm 90/20" 5 $\frac{1}{2}$ " @ 4010  
30/ 3931-86 S/ 1 boph 8 hr. 2000 A  
S/ 24 $\frac{1}{2}$  boph 5 hr. Comp. 397 bopd