


Section 33 Township 8 Range 24W
Well No. #8 Brown "D"
Company Imperial

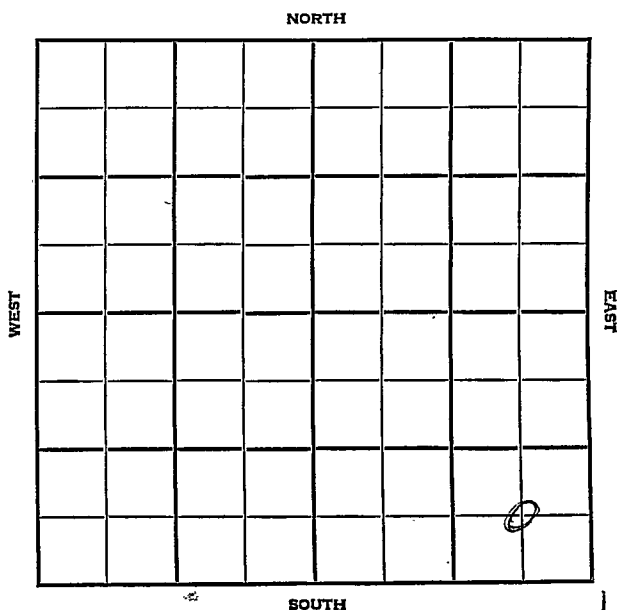

County Graham Elev. _____
 Sec. 33 Twp. 8 Rge. 24W
 Company Imperial
 Farm Name Brown "D" No. 8

TOPS	DEPTH	LOG	DATUM	Loc. in Sec.
Anh.	2165			SE SE
Tr.				
H.				
Tr.				
Dg.				
BL.				
L.				
K.C.				Geol.
B.K.C.				Contr.
Ce.				Arms-Burt
C.				Pool
M.				HOLLY
M.				
K.				
Mz.				
Mo.				
V.				
S.				
S.				
A.				
R.				
PE.				
G.				
T.D.				

Date Comm. 11-25-568 5/8" 186/145, drlg. 2185

NOV 28 1956	
FIRST REPORT	

Co.

Lse.

No.

Sec.

T.

R.

Rid to 1st Rsp

FORM 513 SUNRAY

County Graham Elev. 2469 RB
 Sec. 33 Twp. 8 Rge. 24W 2466D7
 Company Imperial
 Farm Name Brown "D" No. 8

TOPS	DEPTH	LOG	DATUM	Loc in Sec.
Anh.	2165			CSE SE
Tr.				
H.	3762			
Tr.				
Dg.				
BL.				
L.	3801			Geol.
K.C.				Contr.
B.K.C.				Farms - Burt
Ce.				Pool <u>HOLLY</u>
C.				
M.				
M.				
K.				
Mz.				
Mo.				
V.				
S.				
S.				
A.				
R.				
Pe.				
G.				
TD	4021			

COMPLETE
 DEC 26 '56

Date Comm. 11-25-56

8 5/8" 186/145, drlg. 2185 DEC 5 '56

Elev 2469 RB Hh 3762 L59 3801

cr9 @ 3951 DEC 12 '56 Crd 3951-4001

res 56' (S.O. 140' 20' 7) RTD 4021

5 1/2 @ 4021/100 wocT co 16/3955

- 59 550 1/2 \$ 2 1/2 Boph no/w

8 hrs 1 1/2 DEC 19 '56 X 1/2 Total of 1/2

\$ 5 Boph no wtr 12 hrs Pop

DEC 26 '56 X Ph P.

FORM 513-1 SUNRAY

124 Bopd no/wtu L59 PF.
3955-59 RTD 4021

33-8-24