

Graham


KANSAS

SECTION 33 TOWNSHIP 8 RANGE 24W

WELL NO. #9 Brown "D"

COMPANY Imperial Oil

NORTH

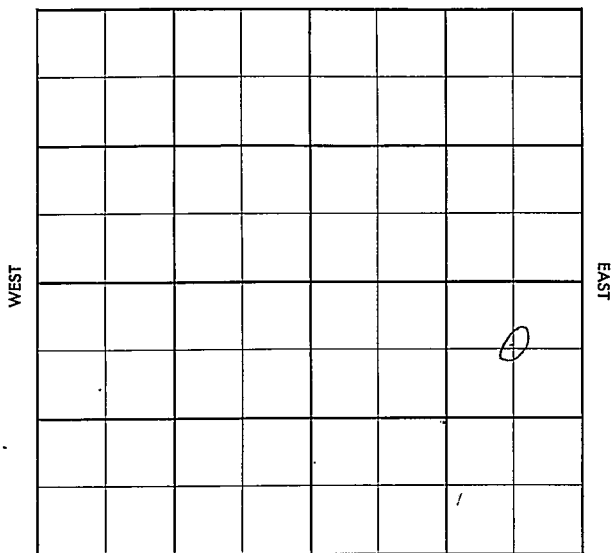

SOUTH

9

County Graham Elev. _____
 Sec. 33 Twp. 8 Rge. 2NW
 Company Imperial Oil
 Farm Name Brown #D# No. 9

TOPS DEPTH LOG DATUM

Anh.			
Tr.			
H.			
Tr.			
Dg.			
Bl.			
L.			
K.C.			
B.K.C.			
Ce.			
C.			
M.			
M.			
K.			
Mz.			
Mq.			
V.			
S.			
S.			
A.			
R.			
Pe.			
G.			
T.D.			

Loc. in Sec. C NE SE

Geol. _____

Contr. Harms-Burt

Pool Holley

DEC 12	7	
FIRST REPORT		
		0

Date Comm. 12-5-56

8" @ 186/150 dwtg. 3330

[Handwritten signature]

Co.

Lse.

No.

Sec.

T.

R.

County Graham Elev. 2450 RB
 Sec. 33 A 8 Rge. 21W
 Company Imperial Oil
 FarmName Brown "D" No. 9

TOPS	DEPTH	LOG	DATUM	Loc. in Sec.
Anh.				C NE SE
TP.				
H.	3748			
Tr.	3771			
Dg.				
Bl.				
L.	3787			
K.C.				Geol.
B.K.C.				Contr.
Ce.				Harms-Burt
C.				
M.				Pool
M.				Holley
K.				
Mz.				
Me.				
V.				
S.				
S.				
A.				
R.				
PE.				
G.				
TD.	3998			

COMPLETE
 JAN 23 '57

Date Comm. 12-5-56

8" @ 186/150 drlg. 3330 : EL. H6
 3748 Tr 3771 Ls9 3787 crd
 3938-88 rec. 50' (Full sec (F) show oil)
 RTD 3998 5 1/2 @ 3998/100 woct
 DEC 26 '56 : woct JAN 2 '57 (MICT
 co 3960 16/3938-42 not st nat.
 1/2" @ 15 Goph now no time
 1/2" @ 1 1/4 Boph now 12 hrs T & R
 Pop 1 1/4 @ 5' * wo tst Ph P.
 50 Boph now 39'