

Graham


KANSAS

SECTION 33 TOWNSHIP 8 RANGE 21 WWELL NO. #5 Brown "D"COMPANY Imperial Drlg.

NORTH

WEST

EAST

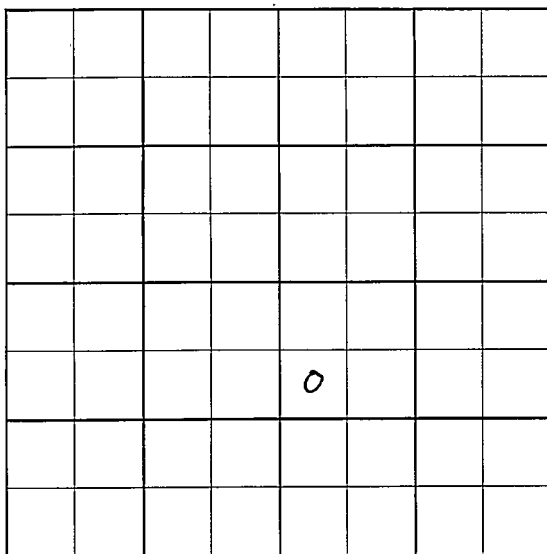

SOUTH

/0

Graham

SEC.	TWP.	R..
33	8	24W

WELL NO.

#5 Brown "D"

FARM

COMPANY

Imperial Drlg.

CONTRACTOR

Co. Tools


NW Holly

Ft. from N. Line

Ft. from S. Line

Ft. from E. Line

Ft. from W. Line

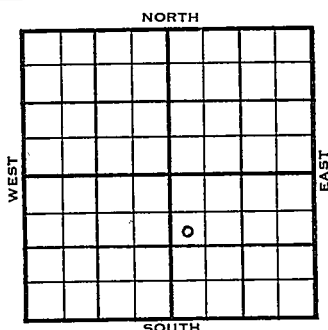

SW NW SE

	ELEVATION	REPORT
1955	2411 KB 2408 DF	
10/19	Loc	
11-23	Comm. 10-19-55 8 5/8" @ 224/200 DST 3883-99 op 1 hr. rec. 20' socm, 50/20" DST 3899-3944 op 1 hr. rec. 2500' gas 1200' oil, 550/20" 5 1/2" @ 3965/100 CO 30/ 3908-12, FU 600' oil 1 hr. S/ 14 boph, 2000 A, S/ 25 boph 10 hr. Comp. BHB 1391 bopd Anh. 2108 L. 3743' T.D. 3965'	

COMPLETED

County

~~Graham~~

Elev.

Sec.

33

Twp.

8

Rge.

21W

Company

~~Imperial Drig.~~

FarmName

~~Brown 1100~~

No.

5

TOPS

DEPTH

LOG

DATUM

Loc. in Sec.

Anh.

Tp.

H.

Tr.

Dg.

Bl.

L.

K.C.

B.K.C.

Ce.

C.

M.

M.

K.

Mz.

Mq.

V.

S.

S.

A.

R.

Pe.

G.

T.D.

SW NW SE

Geol.

Contr.

Co. tools

Pool

NW 1/4 11

FIRST REPORT

OCT 19 1955

Date Comm.

Location

Co.

Lse.

No.

Sec.

T.

R.

2411 KB

2408 DF

County Graham

Elev.

Sec. 33 Twp. 8Rge. 24WCompany Imperial Drlg.Farm Name Brown "D"No. 5

TOPS

DEPTH

LOG

DATUM

Loc. in Sec.

Anh.

2108

SW NW SE

Tp.

H.

Tr.

Dg.

Bl.

L.

.3743

/335

Geol.

K.C.

B.K.C.

Ce.

C.

M.

M.

K.

Mz.

Mq.

V.

S.

S.

A.

R.

Pe.

G.

TD.

.3915

Contr.

Co. tools

Pool

NW Holly

COMPLETE

Date Comm. 10-19-55

NOV 23 1955

8 5/8" @ 224/200 DST 3883-99 open 1 hr

rec. 20' socm 50/20" DST 3899-3944

open 1 hr. Rec. 2500' gas 1200' oil

550/20" TD 3965 5 1/2" @ 3965/100

CO 30/ 3908-12 . FU 600' oil 1 hr.

S/ 1 1/4 boph 2000 A S/ 25 boph 10 hr.

Comp. BHB 1391 bopd