


SECTION 33# TOWNSHIP 8 RANGE 24W

WELL NO. #10 Brown "D"

COMPANY Imperial Oil Co.

NORTH

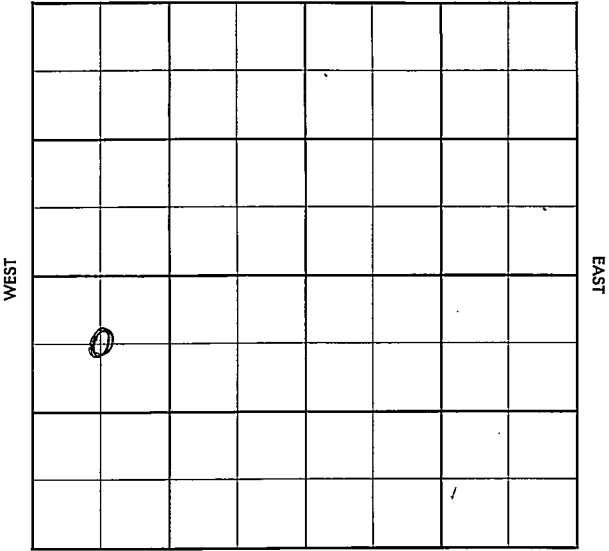

SOUTH

12

County Graham Elev. 2444 RB
 Sec. 33 Twp. 8 Rge. 24W
 Company Imperial Oil Co.
 Farm Name Brown "D" No. 10

TOPS	DEPTH	LOG	DATUM	Loc. in Sec.
Anb.				C N., SW
Ip.				
H.	3738			
Tr.				
Dg.				
Bl.				
L.	3777			
K.C.				Geol.
B.K.C.				Contr.
Ce.				
C.				James-Burt Drlg.
M.				
M.				Pool
K.				olley
Mz.				
Mo.				
V.				
S.				
S.				
A.				
R.				
PE.				
G.				
T.D.	3992			

COMPLETE
 JAN 23 '57

Date Comm. 12-17-56

Drilling surf. C.D. DEC 25 '56; ϕ 3650
 need surf. JAN 2 '57 ϕ 8 5/8 @ 190/150
 H6 3738 659 3777 cored 3925
 -67 run 38 1/2' RTD 3992 no
 Log 5 1/2 @ 3992/125 WOCT
 MICT CO 34/3950-56
 550 16/3929-33 ϕ 5 Goph nol/w
 6 hrs (both 2ns) ^{709 w/DPK 9,3140} Each 20 ft ϕ
 both 2ns ϕ 7 1/2 Boph. nol/w 12 hrs
 Pop Ph P. 123 Bopd + 1070 wts.