


Section 33 Township 8 Range 19W

Well No. 2 Lowry

Company Westgate-Greeland

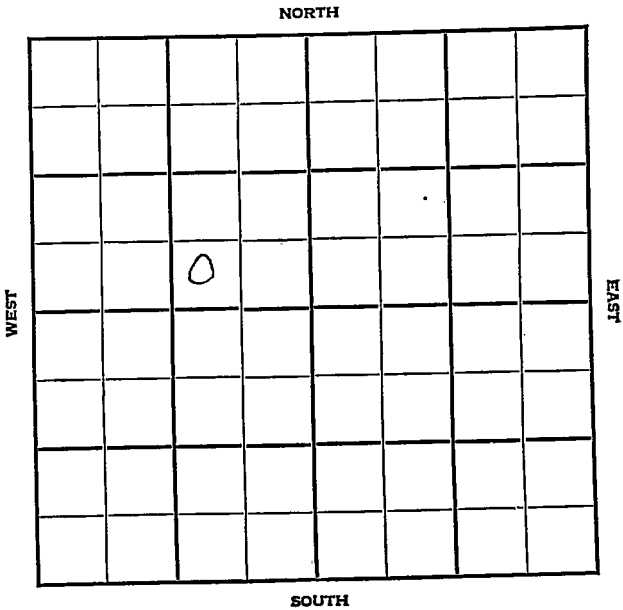

KANSAS Rooks



Sec. 33 Twp. 8 R. 19-W

Well No. #2 Lowery Farm

Westgate-Greenland Company

Barry


 Ft. from N. Line

330 Ft. from S. Line

990 Ft. from E. Line

 Ft. from W. Line

SW SE NW

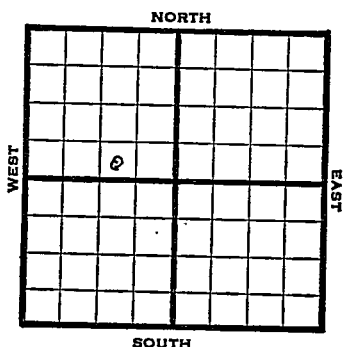

1948

Elev. 2006' REPORT

8/11

10" @ 150'

8/17

WOC

Dr1g 3157'

8/25

Arbuckle 3449'-52'

TD 3452'

9/1

5" @ 3450'

TD 3475'

500 acid

VSSO & W

9/8

Arb 3449'

TD 3490'

ABANDONED

Rocks _____ County Kansas State

Map No. _____ Sec. 33 Twp. 8 R. 19W

Well No. 2 Lowry


Westgate-Greeland _____ Company

FIRST REPORT

_____ Contractor

SW SE NW

SECTION PLAT

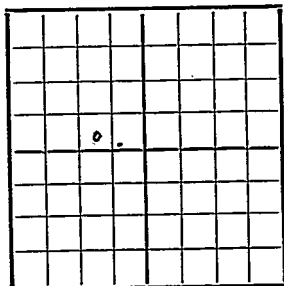

_____ Ft. from N. Line

330 Ft. from S. Line

990 Ft. from E. Line

_____ Ft. from W. Line

Barry Pool

Remarks:

10" @ 150 WOC

Date
AUG 11 1948

Scout

S. J. LEWIS

Barry Pool

Rooks County Kansas State

Map No. 65 Sec. 33 Twp. 8 R. 19W

Well No. 2 Lowry

Westgate-Greenland Company

ABANDONED Contractor

SW SE NW

E1,2006
SECTION PLAT

 Ft. from N. Line

330 Ft. from S. Line

990 Ft. from E. Line

 Ft. from W. Line

Barry Pool

Remarks:

Cr 83449

YIT 83490

Date

SEP 8 1948

Scout

S. J. LEWIS