


KANSAS

Section 33 Township 8 Range 19 WWell No. #1 FibleisCompany Phillips

Handwritten: 1 1/2

Rooks

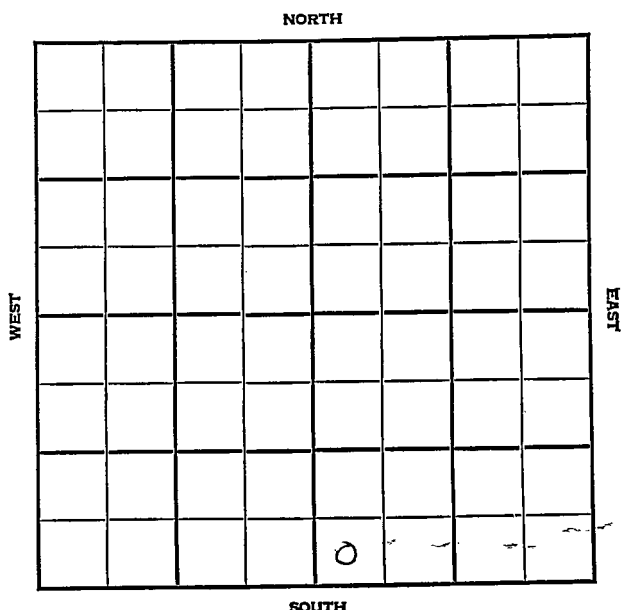

Sec. 33 Twp. 8 R. 19W

Well No. #1 Fibleis Farm

Phillips Company

Barry Pool


 Ft. from N. Line

330' Ft. from S. Line

 Ft. from E. Line

330' Ft. from W. Line

SW SE

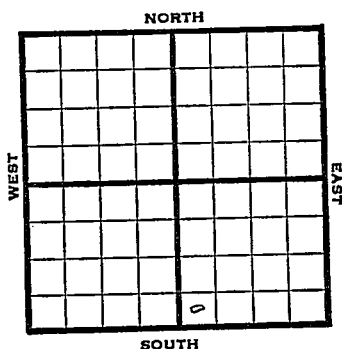

1948

Eli 2006'

REPORT

6/16 Location
6/23 8" @ 1463'
WOC
6/29 Lansing 3191'
Drlg. 3282'
7/8 Arbuckle 3435'
TD 3439'
SO
5" @ 3436'
RUST
7/14 TD 3443
swb 91 Oil
7/21 "
7/28 "
8/4 "
8/11 500 acid
Pump 108 bbls oil 11½ hrs.
8/18 Arb. 3435'
5" @ 3436'
TD 3443'
500 acid
Echo Pot 3000 oil
275 Gr.
Comp

COMPLETED

Map No. _____ Sec. 33 Twp. 8 R. 19W


Well No. 1 Fibleis

Phillips Company

FIRST REPORT Contractor

SW SE

SECTION PLAT

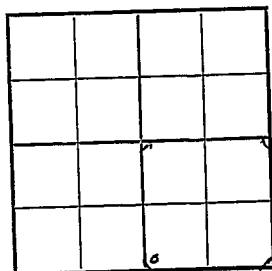

_____ Ft. from N. Line

330 Ft. from S. Line

_____ Ft. from E. Line

330 Ft. from W. Line

Rooks County

Location X

Rig up _____

Drilling and Remarks:

RECORD

Cased _____ in., _____ ft.

Sand _____

Gas _____

Oil _____

Total Depth _____

PRODUCTION

1st 24 hrs. Nat. _____

1st 24 hrs. after shot _____

Gas _____ Cu. Ft.

Dry Hole _____

Abandoned _____

Date

JUN 16 1948 19 _____ S. J. LEWIS Scout

