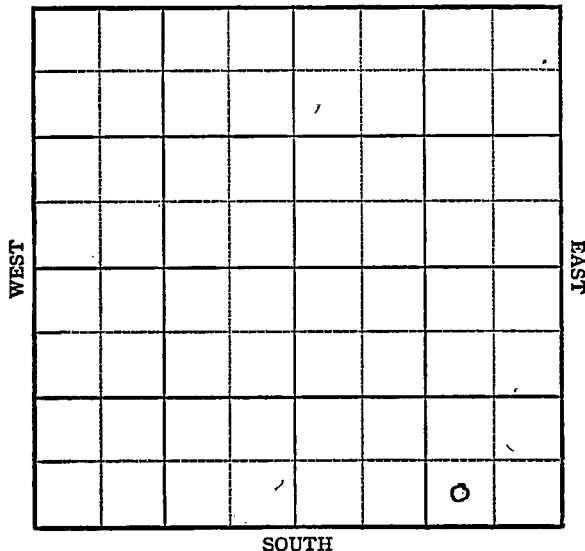


KANSAS

Rooks

Section 33 Township 8 Range 19WWell No. 3 FiedlisCompany PhillipsBarry Pool
NORTH

Sec. 33 Twp. 8 R. 19-W ✓

Well No. #3 Fiedlis Farm _____

Phillips

Company _____

Barry Pool

_____ Ft. from N. Line

330


Ft. from S. Line

990

Ft. from E. Line

_____ Ft. from W. Line

SW S E SE

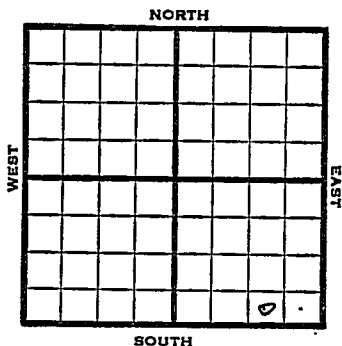

1948

Eli 1994'

R E P O R T

10/6

Location

10/13

"

10/19

8" @ 1450'

Drlg 1510'

10/26

Drlg 3282'

11/3

Lansing 3179'

Arbuckle 3420'

TD 3423

5" @ 3421'

11/10

Swb 38 oil 1 hr.

11/16

"

11/23

"

11/30

500 acid

Pump 258 bbls oil 24 hrs.

12/8

TD 3423'

Arb. 3420'

5" @ 3421'

500 acid

Depth Pot 3000 Oil

28° Gr.

Comp

COMPLETED


Map No. _____ Sec. 33 Twp. 8 R. 19WWell No. 3 Fiedlis

_____ Phillips _____ Company

_____ FIRST REPORT _____ Contractor

SW SE SE

SECTION PLAT

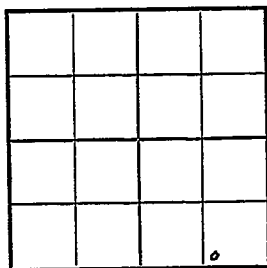

_____ Ft. from N. Line

330 Ft. from S. Line990 Ft. from E. Line

_____ Ft. from W. Line

Rooks County

Location X

Rig up _____

Drilling and Remarks:

RECORD

Cased _____ in., _____ ft.

Sand _____

Gas _____

Oil _____

Total Depth _____

PRODUCTION

1st 24 hrs. Nat. _____

1st 24 hrs. after shot _____

Gas _____ Cu. Ft.

Dry Hole _____

Abandoned _____

Date

OCT 6 1948 19S. J. LEWIS Scout

Map No. 65 Sec. 33 Twp. 8 R. 19W

Well No. 3 Fiedlis

Phillips Company

COMPLETE

Contractor

SW SE SE


E1, 1994
SECTION PLAT

 Ft. from N. Line

330 Ft. from S. Line

990 Ft. from E. Line

 Ft. from W. Line

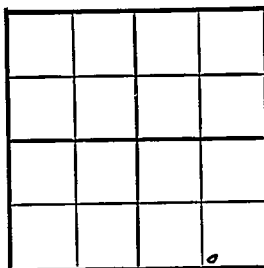

Rooks County

Location

Rig up

Drilling and Remarks:

CU 3420

5' 3421



2824

RECORD

Cased in., ft.

Sand

Gas

Oil

Total Depth 3423

PRODUCTION

1st 24 hrs. Nat.

1st 24 hrs. after shot

Gas Cu. Ft.

Dry Hole

Abandoned

Date

DEC 8 1948 19

S. J. LEWIS Scout