

KANSAS

Rooks

Section 33 Township 8 Range 19W

Well No. 4 Fibleis

Company Phillips

Webster
NORTH

							o

WEST

EAST

SOUTH

KANSAS

Rooks

Sec. 33 Twp. 8 R. 19W

Well No. #4 Fibleis Farm

Phillips Company

Webster Pool


330' Ft. from N. Line

Ft. from S. Line

330' Ft. from E. Line

Ft. from W. Line

NE SE

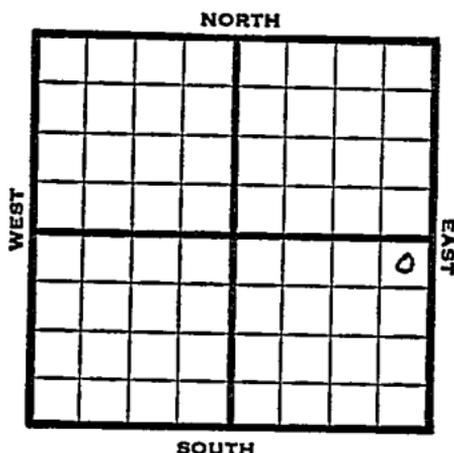

1949

Elev 1980' REPORT

- 4/6 Location
- 4/12 "
- 4/20 "
- 4/27 Drlg 1115'
- 5/4 8" @ 182'
- Lansing 3166'
- Drlg 3311'
- 5/10 Arb. 3408' - 11'
- TD 3411'
- 5" @ 3409'
- 5/18 TD 3415'
- Swb 36 bb 1s oil 1/2 hrs.
- 5/25 "
- 6/1 "
- 6/8 "
- 6/15 Arb. 3408'
- 5" @ 3409'
- TD 3415'
- Pump 397 Oil / 30 W Pot
- 27° Gr.
- Comp

COMPLETED

Map No. _____ Sec. 33 Twp. 8 R. 19W

Well No. 4 Fibleis

Phillips Company

FIRST REPORT

Contractor

NE SE

SECTION PLAT

330 Ft. from N. Line

_____ Ft. from S. Line

330 Ft. from E. Line

_____ Ft. from W. Line

			o

Rooks County

Location X

Rig up _____

Drilling and Remarks:

RECORD

Cased _____ in., _____ ft.

Sand _____

Gas _____

Oil _____

Total Depth _____

PRODUCTION

1st 24 hrs. Nat. _____

1st 24 hrs. after shot _____

Gas _____ Cu. Ft.

Dry Hole _____

Abandoned _____

Date

APR 6 1949 19

S. J. LEWIS Scout

Rooks County Kansas State

Map No. K 65 Sec. 33 Twp. 8 R. 19W

Well No. 4 Fibleis

Phillips Company

COMPLETE

Contractor

NE SE

E 11, 1980
SECTION PLAT

							o

330 Ft. from N. Line

 Ft. from S. Line

330 Ft. from E. Line

 Ft. from W. Line

Webster Pool

Remarks:

at 3408.

5' @ 3409

at 3415.

Run 397 oil + 30W oil

27 0/80

Date

Scout

JUN 15 1949