

C.W.W.O.

KANSAS

Rooks

Section 33 Township 8 Range 19W

Well No. 5 Fidelis

Company Phillips

Webster Pool

NORTH

WEST

EAST

					0		

SOUTH

Sec. 33 Twp. 8 R. 19W

Well No. 5 Fidelis Farm _____

Phillips

Company _____


Webster Pool

330 Ft. from N. Line

_____ Ft. from S. Line

_____ Ft. from E. Line

990 Ft. from W. Line

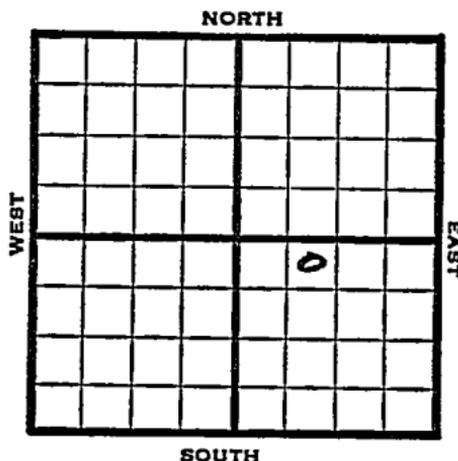

NE NW SE

1949 Elev 1981' REPORT

9/28 Loc.

10/5 8" @ 1431'
Drlg 2830'

10/12 Lansing 3173'
BKC 3390'
Arb. 3415'-18'
TD 3418'
5" @ 3416'

10/19 TD 3422'
3 Oil / 3W PH

10/26 "

11/2 TD 3422'
Arb. 3415'
5" @ 3416'
Pump 81 Oil / 60W Pot
27° Gr.
Comp

COMPLETED

OVER

O.W.W.O.

1955
3/2

SWD Well
TD 3422'
Howard 2927', Heeb.3135', Tor.3154'
KC 3173', B KC 3390', Arb.3415'
TD 3422'
5" @ 3416'
PB 3399'
28/3365-72
S/3 bw 5 hrs., 500A
S/1.90 bo 112 bw 13 hrs.
PB 3360'
Perf/3345-49, S/7 bw 500A
S/ 1 3/4 bo 81 bw 9 hrs.
PB 3335'
Perf/3332-72, S/2 bw SS Free oil
1 hr., perf/3308-15, S/1 1/2 bo 69 bw
7 hrs.
PB 3245', perf/3212-17, S/27 gw
stan oil 3 hrs., 500A
S/2.08 bo 90 bw 7 hrs.
S/58 bw 4 hrs.
PB 3170'
20/3156-61
B/3 bw 5 hrs., 500A
S/135 bw 7 hrs.
PB 3165'
Comp. SWD Well

FIRST REPORT

ABANDONED

County **Rocks** State **Kansas**
 Sec. **33** (Blk. **8**) (Sur. **19W**) Map No.
 Operator **Phillips Pet.**
 Well No. **5** Farm **Fidelis** **O.W.W.O.**
 Elev. **1981** Location **NE NW SE**

FIRST REPORT					
ABANDONED					

330 Ft. From **N** Line **SE**
990 Ft. From **W** Line **Quarter**
 Ist. Report **MAR 2 1955**
 Completion **MAR 2 1955**
 Remarks **O.W.W.O.**

Drig. Data **SWD well** **TD 3422** **O.W.W.O.**
Howard 2927 Heeb. 3135 Tor. 3154
KC 3173 B KC 3390 Arb. 3415 TD 3422
5" @ 3416 PB 3399 28/ 3365-72
S/ 3 bw 5 hr. 500 A S/ 1.90 bo
112 bw 13 hr. PB 3360 perf/ 3345-49
S/ 7 bw 500 A S/ 1 3/4 bo 81 bw 9 hr.
PB 3335 perf/ 3332-72 S/ 2 bw SS free
oil 1 hr. perf/ 3308-15 S/ 1 1/2 bo
69 bw 7 hr. PB 3245 perf/ 3212-17
S/ 27 gw stain oil 3 hr. 500 A
S/ 2.08 bo 90 bw 7 hr. S/ 58 bw 4 hr.
PB 3170 20/ 3156-61 B/ 3 bw 5 hr.
500 A S/ 135 bw 7 hr. PB. 3165
 Comp. SWD well

FABEN GILSTRAP

Map No. _____ Sec. 33 Twp. 8 R. 19W

Well No. 5 Fidelis

Phillips Company

Contractor

NE NW SE

FIRST REPORT
SECTION PLAT

330 Ft. from N. Line

_____ Ft. from S. Line

_____ Ft. from E. Line

990 Ft. from W. Line

Rooks County

RECORD

Location X

Cased _____ in., _____ ft.

Rig up _____

Sand _____

Drilling and Remarks:

Gas _____

Oil _____

Total Depth _____

PRODUCTION

1st 24 hrs. Nat. _____

1st 24 hrs. after shot _____

Gas _____ Cu. Ft.

Dry Hole _____

Abandoned _____

Date

SEP 28 1949 19

S. J. LEWIS Scout

Kansas

Map No. _____ Sec. 33 Twp. 8 R. 19W

Well No. 5 Fidelis

Phillips Company

COMPLETE

Contractor

NE NW SE

E. 1981
SECTION PLAT

330 Ft. from N. Line

_____ Ft. from S. Line

_____ Ft. from E. Line

990 Ft. from W. Line

		o	

Rooks County

RECORD

Location _____

Cased _____ in., _____ ft.

Rig up _____

Sand _____

Drilling and Remarks:

Gas _____

Cor 3415

Oil _____

5" @ 3416

Total Depth: *3422*

Pump Oil 6 + 60W

PRODUCTION

1st 24 hrs. Nat. _____

1st 24 hrs. after shot _____

Gas _____ Cu. Ft.

Dry Hole _____

Abandoned _____

27° SW

Date

NOV 2 1949 19

S. J. LEWIS Scout