


Section 33 Township 8 Range 19W

Well No. #6 Fidelis

Company Phillips Pet.

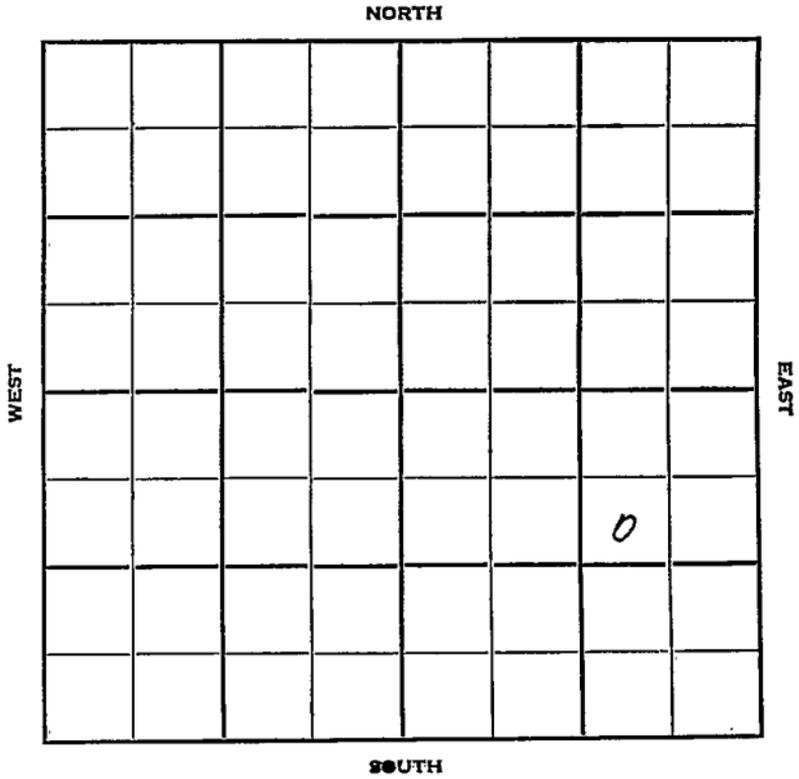

Sec. 33 Twp. 8 R. 19W ✓

Well No. #6 Fidelis Farm

Phillips Pet. Company

Phillips Contractor


Webster Pool

990' Ft. from N. Line

_____ Ft. from S. Line

990' Ft. from E. Line

_____ Ft. from W. Line

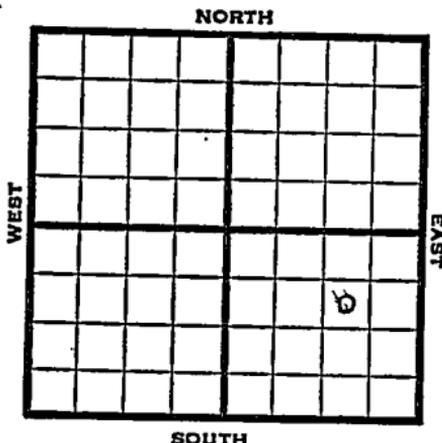

SW NE SE

1951 Elev. 1993' REPORT

6/6 RUR

8/1 Spud 6-6-51
 Oil well TD 3429' Anhy 1400'
 8" @ 1407' Howard 2933' Top 3960'
 Heeb 3140' Tor 3160' Lans. 3180'
 Arb. 3422' TD 3425' 5" @ 3424
 test 1 pt. oil DD 3429' FU 80'
 oil 2 hr. S/3/4 BOPH 300 A
 S/ 16 BO 5 BWPH
 Comp. 97 BOPD 180 BW

COMPLETED

