


Section 33 Township 8 Range 19W

Well No. #7 Fidellas

Company Phillips Pet.

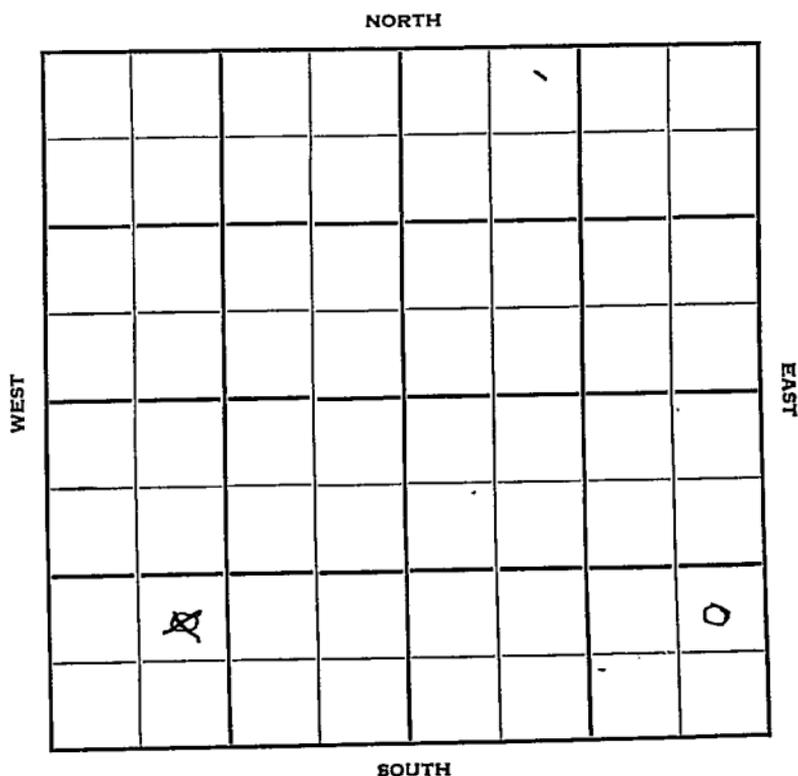

Rooks
8

KANSAS

33

19W

Sec. _____ Twp. _____ R. _____

Well No. #7 Fiedllas Farm

Phillips Pet. Company

Phillips - Contr. Contractor


_____ Ft. from N. Line

990' Ft. from S. Line

330' Ft. from E. Line

_____ Ft. from W. Line

NE SE SE

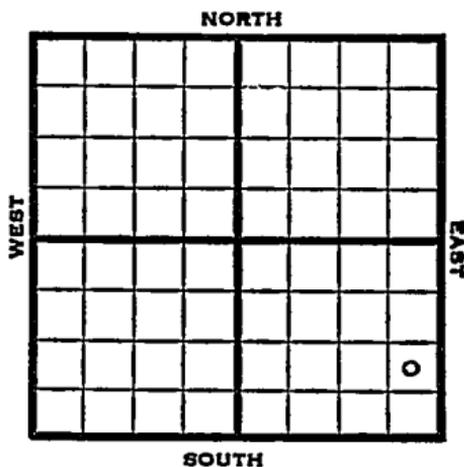

1951

Elev. 1991' REPORT

8/22
10/10

Location
Spud 8-18-51
Oil Well TD 3424
8" @ 1414 Anhy 1405
Howard 2932 Top 2958
Heeb. 3138 Tor. 3157
Lans. 3178 BKG 3397
Arb. 3421-23
5" @ 3421 TD 3424 SSO
300 A S/21 Bo 71 bw 3 hr.
S/28 bo 76 bw 3 hr.
S/57 bo 243 bw 6 hr.
P/115 bo 90 bw 8 hr.
P/33 bo 52 bw 6 hr.
Comp. 127 bo 230 bwpd

COMPLETED

