

Rooks county


FORM 51 5M 6-46 PETROL

KANSAS

Section 33 Township 8 Range 19-W

Well No. #1, Lowey

Company Amerada Petroleum

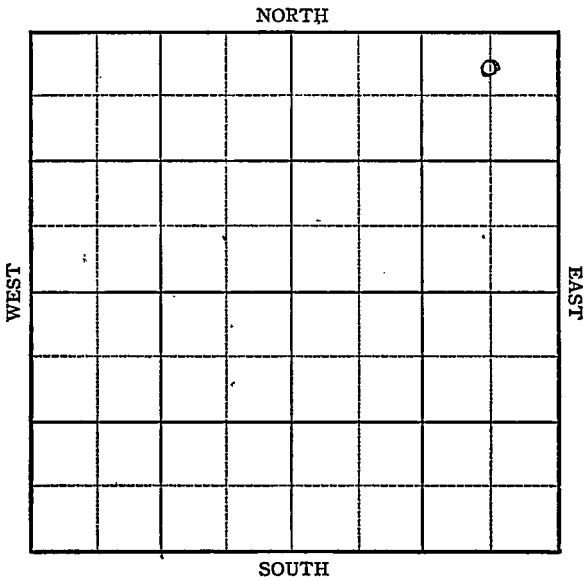

KANSAS

Rooks

Sec. 33 Twp. 8-S R. 19-W

Well No. #1 Lowey Farm
Amerada Company


330' Ft. from N. Line

_____ Ft. from S. Line

660' Ft. from E. Line

_____ Ft. from W. Line

C N L NE NE

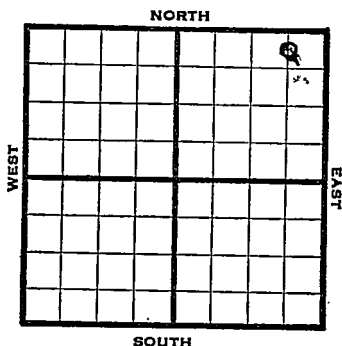

1946 Elev 1988 - REPORT

9/5 Location

9/10 RUR

9/18 Anhy 1402'
8" @ 1420
Drl g 2818'

9/25 Arb 3436'
TD 3484'

ABANDONED

KANSAS

Kansas

Pool Name VerverkaMap No. 65 Sec. 33 Twp. 8 R. 19WWell No. 1 LoweyAmerada


Company

FIRST REPORT

Contractor

C N L NE NE

SECTION PLAT

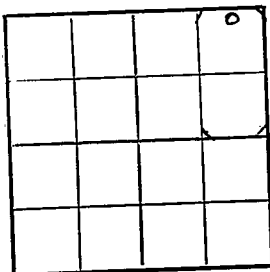330 Ft. from N. Line Ft. from S. Line660 Ft. from E. Line Ft. from W. Line

Rooks County

Location XRig up

Drilling and Remarks:

RECORD

Cased in., ft.Sand Gas Oil Total Depth

PRODUCTION

1st 24 hrs. Nat. 1st 24 hrs. after shot Gas Cu. Ft.Dry Hole Abandoned

Date

SEP 5 1946 19S. J. LEWIS

Scout

KANSAS Kansas Pool Name VerverkaMap No. 65 Sec. 33 Twp. 8 R. 19WWell No. 1 LoweyAmerada

Company

ABANDONED

Contractor

C N L NE NE

E 11988
SECTION PLAT330 Ft. from N. Line Ft. from S. Line660 Ft. from E. Line Ft. from W. Line

			0

Rooks County

Location Rig up

Drilling and Remarks:

Art 3436**RECORD**Cased in., ft.Sand Gas Oil Total Depth 3484**PRODUCTION**1st 24 hrs. Nat. 1st 24 hrs. after shot Gas Cu. Ft.Dry Hole Abandoned

Date

SEP 25 1946 19S. J. LEWIS

Scout