


Section 33 Township 8 Range 19 W

Well No. #1 Lowry

Company Westgate-Greenland

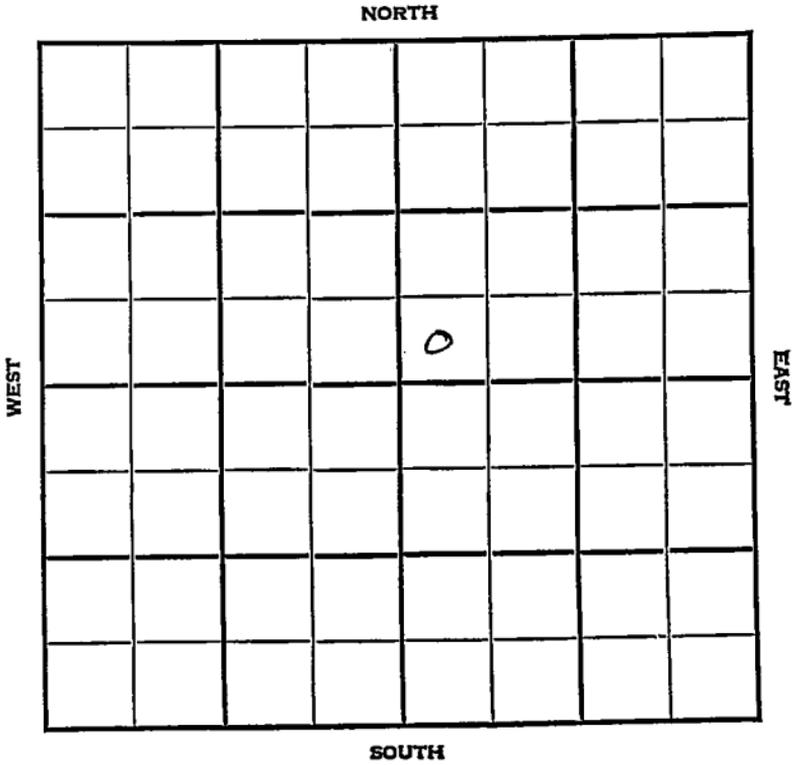

KANSAS

Rooks

19W



Sec. 33 Twp. 8 R. 19W

Well No. #1 Lowry Farm
Westgate-Greenland Company

Ververka Pool


Ft. from N. Line

330' Ft. from S. Line

Ft. from E. Line

330' Ft. from W. Line

SW NE

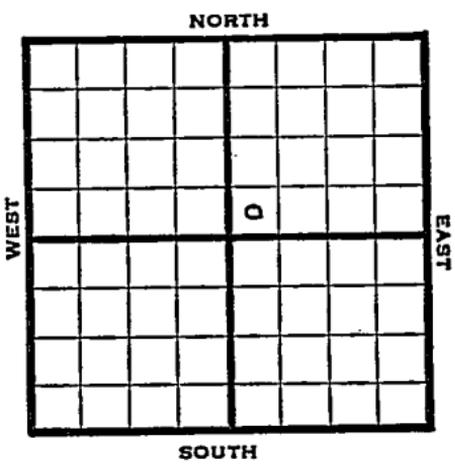

1948

Elev. 2012' REPORT

7/8	10" @ 158'	
	Drlg. 1248	
7/14	Drlg 3210'	
7/21	Lansing 3208'	
	Arbuckle 3449'	
	TDD 3454'	
	5" @ 3449'	
	RUST	
7/28	"	
8/4	PB 3452'	
	Swab 2 bbls. oil PH	
8/11	"	"
8/17	"	"
8/25	"	"
9/1	"	"
9/8	"	"
9/14	"	"
9/21	"	"
9/29	"	"
10/6	"	"
10/13	"	"
10/19	"	"
10/26	"	"
11/3	"	"
11/10	"	"
11/16	"	"
11/23	"	"

OVER

1948

11/30

PB 3452

Swb 2 bbls oil PH

12/8

"

12/15

"

12/22

Arb 3449

5" @ 3449'

Pump 35 oil & 27 W Pot.

Gr. 27°

TD 3454'

COMPLETED

Map No. _____ Sec. 33 Twp. 8 R. 19W

Well No. 1 Lowry

Westgate-Greenland Company

FIRST REPORT Contractor

SW NE


SECTION PLAT

_____ Ft. from N. Line

330 Ft. from S. Line

_____ Ft. from E. Line

330 Ft. from W. Line

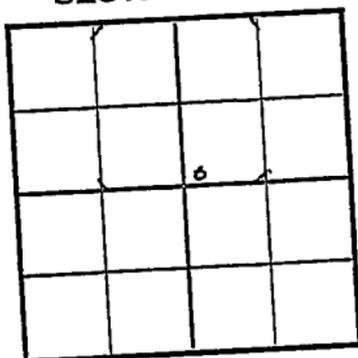

Rooks County

Location _____

Rig up _____

Drilling and Remarks:

10" @ 158

drlg. 1248

RECORD

Cased _____ in., _____ ft.

Sand _____

Gas _____

Oil _____

Total Depth _____

PRODUCTION

1st 24 hrs. Nat. _____

1st 24 hrs. after shot _____

Gas _____ Cu. Ft.

Dry Hole _____

Abandoned _____

Date

JUL 8 1948 19

S. J. LEWIS Scout

